

WATER WELL RECORD Form WWC-5


☐ Original Record ☐ Correction ☐ Change in Well Use

Division of Water
Resources App. No.

Well ID **MW-2**

1 LOCATION OF WATER WELL: County: SALINE	Fraction $\frac{1}{4}$ $\frac{1}{4}$ NW $\frac{1}{4}$ SE $\frac{1}{4}$	Section Number 12	Township Number T 14 S	Range Number R 3 <input type="checkbox"/> E <input checked="" type="checkbox"/> W
---	---	-----------------------------	----------------------------------	---

2 WELL OWNER: Last Name: CHOPP Business: MARION L CHOPP TRUST Address: P.O. BOX 167 Address: City: SALINA State: KS ZIP: 67402-0167	First: MARION	Street or Rural Address where well is located (if unknown, distance and direction from nearest town or intersection): If at owner's address, check here: <input type="checkbox"/> 616 E. NORTH STREET SALINA KS 67401
--	----------------------	---

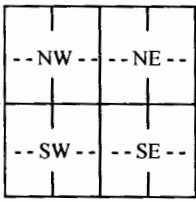3 LOCATE WELL WITH "X" IN SECTION BOX: N  S 1 mile	4 DEPTH OF COMPLETED WELL: 45 ft. Depth(s) Groundwater Encountered: 1) ft. 2) ft. 3) ft., or 4) <input type="checkbox"/> Dry Well WELL'S STATIC WATER LEVEL: 32.1 ft. <input checked="" type="checkbox"/> below land surface, measured on (mo-day-yr) 01/9/19 <input type="checkbox"/> above land surface, measured on (mo-day-yr) Pump test data: Well water was ft. after hours pumping gpm Well water was ft. after hours pumping gpm Estimated Yield: gpm Bore Hole Diameter: 4 in. to 20 ft. and 3.25 in. to 45 ft.	5 Latitude: 38.848613 (decimal degrees) Longitude: 97.601957 (decimal degrees) Horizontal Datum: <input type="checkbox"/> WGS 84 <input checked="" type="checkbox"/> NAD 83 <input type="checkbox"/> NAD 27 Source for Latitude/Longitude: <input type="checkbox"/> GPS (unit make/model:) (WAAS enabled? <input type="checkbox"/> Yes <input type="checkbox"/> No) <input type="checkbox"/> Land Survey <input type="checkbox"/> Topographic Map <input type="checkbox"/> Online Mapper:
	6 Elevation: ft. <input type="checkbox"/> Ground Level <input type="checkbox"/> TOC Source: <input type="checkbox"/> Land Survey <input type="checkbox"/> GPS <input type="checkbox"/> Topographic Map <input type="checkbox"/> Other	

7 WELL WATER TO BE USED AS: 1. Domestic: <input type="checkbox"/> Household <input type="checkbox"/> Lawn & Garden <input type="checkbox"/> Livestock 2. <input type="checkbox"/> Irrigation 3. <input type="checkbox"/> Feedlot 4. <input type="checkbox"/> Industrial 5. <input type="checkbox"/> Public Water Supply: well ID 6. <input type="checkbox"/> Dewatering: how many wells? 7. <input type="checkbox"/> Aquifer Recharge: well ID 8. <input checked="" type="checkbox"/> Monitoring: well ID MW-2 9. Environmental Remediation: well ID <input type="checkbox"/> Air Sparge <input type="checkbox"/> Soil Vapor Extraction <input type="checkbox"/> Recovery <input type="checkbox"/> Injection 10. <input type="checkbox"/> Oil Field Water Supply: lease 11. Test Hole: well ID <input type="checkbox"/> Cased <input type="checkbox"/> Uncased <input type="checkbox"/> Geotechnical 12. Geothermal: how many bores? a) Closed Loop <input type="checkbox"/> Horizontal <input type="checkbox"/> Vertical b) Open Loop <input type="checkbox"/> Surface Discharge <input type="checkbox"/> Inj. of Water 13. <input type="checkbox"/> Other (specify):		
--	--	--

Was a chemical/bacteriological sample submitted to KDHE? ☐ Yes ☒ No If yes, date sample was submitted:

Water well disinfected? ☐ Yes ☒ No

8 TYPE OF CASING USED: <input type="checkbox"/> Steel <input checked="" type="checkbox"/> PVC <input type="checkbox"/> Other Casing diameter 1 in. to 45 ft., Diameter in. to ft., Diameter in. to ft. Casing height above land surface 0 in. Weight lbs./ft. Wall thickness or gauge No. SCH 40	CASING JOINTS: <input type="checkbox"/> Glued <input type="checkbox"/> Clamped <input type="checkbox"/> Welded <input checked="" type="checkbox"/> Threaded
--	--

TYPE OF SCREEN OR PERFORATION MATERIAL:
☐ Steel ☐ Stainless Steel ☐ Fiberglass ☒ PVC ☐ Other (Specify)
☐ Brass ☐ Galvanized Steel ☐ Concrete tile ☐ None used (open hole)

SCREEN OR PERFORATION OPENINGS ARE:
☐ Continuous Slot ☒ Mill Slot ☐ Gauze Wrapped ☐ Torch Cut ☐ Drilled Holes ☐ Other (Specify)
☐ Louvered Shutter ☐ Key Punched ☐ Wire Wrapped ☐ Saw Cut ☐ None (Open Hole)

SCREEN-PERFORATED INTERVALS: From 35 ft. to 45 ft., From ft. to ft., From ft. to ft.
GRAVEL PACK INTERVALS: From 33 ft. to 46 ft., From ft. to ft., From ft. to ft.

9 GROUT MATERIAL: <input type="checkbox"/> Neat cement <input type="checkbox"/> Cement grout <input checked="" type="checkbox"/> Bentonite <input type="checkbox"/> Other Grout Intervals: From 3 ft. to 33 ft., From ft. to ft., From ft. to ft.	CEMENTED FROM 0 TO 3 FT
---	--------------------------------

Nearest source of possible contamination:
☐ Septic Tank ☐ Lateral Lines ☐ Pit Privy ☐ Livestock Pens ☐ Insecticide Storage
☐ Sewer Lines ☐ Cess Pool ☐ Sewage Lagoon ☐ Fuel Storage ☐ Abandoned Water Well
☐ Watertight Sewer Lines ☐ Seepage Pit ☐ Feedyard ☐ Fertilizer Storage ☐ Oil Well/Gas Well
☐ Other (Specify)
 Direction from well? Distance from well? ft.

10 FROM	TO	LITHOLOGIC LOG	FROM	TO	LITHO. LOG (cont.) or PLUGGING INTERVALS
0	.5	FILL MATERIAL	33	34	SAND WITH LITTLE SILT, TAN
.5	2.5	SILT WITH CLAY, BROWN, MOIST	34	45	SAND WITH LITTLE FINE GRAVEL
2.5	16	SILT WITH LITTLE CLAY, BROWN			
16	21	SILT WITH VERY FINE SAND, TAN			
21	23.5	SAND WITH SOME SILT TAN			
23.5	24.5	SILT AND CLAY, BROWN			
24.5	28	SILT WITH LITTLE SAND, TAN	Notes:		
28	29	CLAY WITH SILT AND LITTLE SAND			
29	33	SILT AND SAND WITH LITTLE CLAY			

11 CONTRACTOR'S OR LANDOWNER'S CERTIFICATION: This water well was ☒ constructed, ☐ reconstructed, or ☐ plugged under my jurisdiction and was completed on (mo-day-year) **01/8/2019** and this record is true to the best of my knowledge and belief.
 Kansas Water Well Contractor's License No. **709** This Water Well Record was completed on (mo-day-year) **01/10/2019**
 under the business name of **PLAINS ENVIRONMENTAL SERVICES, INC.** Signature

Saline

12-T14-R3W



Figure 1: 616 East North Street Site – Monitor Well Locations

RECEIVED

FEB 05 2019

BUREAU OF WATER

Salina

12-T14-R3W

742 DUVALL AVE
SALINA, KANSAS 67401
www.kveng.com

TEL: 785-823-3400

MOINTOR WELL REPORT

616 EAST NORTH STREET- SALINA, KANSAS


KVE PROJECT NUMBER E19S2213

MONITOR WELL NUMBER	COORDINATES		ELEVATIONS		DISTANCE FROM SE COR. S12-T14S-R3W	
	NORTHING	EASTING	TOP OF CASING	GROUND	NORTH	WEST
MW-1	187951.05	1425657.70	1222.47	1222.9	2582'	2315'
MW-2	187901.80	1425699.40	1222.50	1222.7	2532'	2273'
MW-3	187881.85	1425623.70	1222.21	1222.8	2513'	2349'
MW-4	187728.32	1425657.08	1221.75	1222.0	2359'	2316'
MW-5	187740.55	1425517.67	1221.55	1221.8	2371'	2455'
MW-6	187595.99	1425627.53	1222.62	1223.0	2227'	2345'

(1) COORDINATES ARE TO THE NORTH SIDE OF CASING PIPE.
COORDINATES ARE BASED ON KANSAS STATE PLANE NORTH, ZONE 1501, NAD 1983 U.S. SURVEY FEET.

(2) ELEVATIONS ARE BASED ON NAVD 1988 U.S. SURVEY FEET.

CERTIFICATION: THIS SURVEY WAS PERFORMED BY ME OR UNDER MY DIRECT SUPERVISION AND IS TRUE AND ACCURATE TO THE BEST OF MY BELIEF.

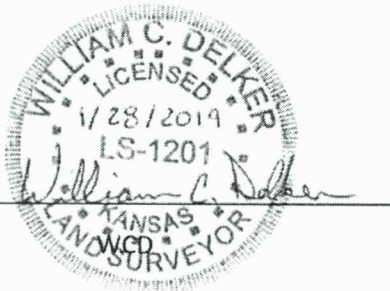

RECEIVED
FEB 05 2019
BUREAU OF WATER