

## WATER WELL PLUGGING RECORD Form WWC-5P

KSA 82a-1212

ID NO.

MW-1


| <b>1 LOCATION OF WATER WELL:</b><br>County: <u>Saline</u><br>Street/Rural Address of Well Location; if unknown, distance & direction from nearest town or intersection: If at owner's address, check here <input type="checkbox"/> 303 S. Santa Fe Salina, KS   | Fraction <u>NW 1/4 SE 1/4 SW 1/4 NW 1/4</u><br>Section Number <u>13</u><br>Township Number <u>T 14 S</u><br>Range Number <u>3</u> <input type="checkbox"/> E <input checked="" type="checkbox"/> W | <b>Global Positioning Systems (GPS) information:</b><br>Latitude: <u>38.83574</u> (in decimal degrees)<br>Longitude: <u>97.60892</u> (in decimal degrees)<br>Elevation: <u>1226.62</u> TOC<br>Horizontal Datum: <input type="checkbox"/> WGS84, <input checked="" type="checkbox"/> NAD83, <input type="checkbox"/> NAD27<br>Collection Method: _____<br><input type="checkbox"/> GPS unit (Make/Model: _____)<br><input type="checkbox"/> Digital Map/Photo, <input type="checkbox"/> Topographic Map, <input checked="" type="checkbox"/> Land Survey<br>Est. Accuracy: <input checked="" type="checkbox"/> < 3 m, <input type="checkbox"/> 3-5 m, <input type="checkbox"/> 5-15 m, <input type="checkbox"/> > 15 m | |
|---|
| <b>2 WATER WELL OWNER:</b> KDHE-BER<br>RR#, St. Address, Box #: 1000 SW Jackson<br>City, State ZIP Code: Topeka, KS 66612   | <b>3 MARK WELL'S LOCATION WITH AN "X" IN SECTION BOX:</b><br><div style="text-align: center;"> </div>                                                                                              | |
| <b>4 DEPTH OF WELL</b> <u>48.00</u> ft.<br>WELL'S STATIC WATER LEVEL <u>34.15</u> ft.<br>WELL WAS USED AS:<br><div style="display: flex; justify-content: space-between;"> <div> <input type="checkbox"/> Domestic<br/> <input type="checkbox"/> Irrigation<br/> <input type="checkbox"/> Feedlot<br/> <input type="checkbox"/> Industrial         </div> <div> <input type="checkbox"/> Public Water Supply<br/> <input type="checkbox"/> Oil Field Water Supply<br/> <input type="checkbox"/> Domestic (Lawn &amp; Garden)<br/> <input type="checkbox"/> Air Conditioning         </div> <div> <input type="checkbox"/> Dewatering<br/> <input checked="" type="checkbox"/> Monitoring<br/> <input type="checkbox"/> Injection Well<br/> <input type="checkbox"/> Other _____         </div> </div> Was a chemical/bacteriological sample submitted to Department? Yes <input type="checkbox"/> No <input checked="" type="checkbox"/>   | |
| <b>5 TYPE OF BLANK CASING USED:</b><br><div style="display: flex; justify-content: space-between;"> <div> <input type="checkbox"/> Steel<br/> <input checked="" type="checkbox"/> PVC         </div> <div> <input type="checkbox"/> RMP (SR)<br/> <input type="checkbox"/> ABS         </div> <div> <input type="checkbox"/> Wrought<br/> <input type="checkbox"/> Asbestos-Cement         </div> <div> <input type="checkbox"/> Fiberglass<br/> <input type="checkbox"/> Concrete Tile         </div> <div> <input type="checkbox"/> Other (Specify below) _____         </div> </div> Blank casing diameter <u>2</u> in. Was casing pulled? Yes <input checked="" type="checkbox"/> No <input type="checkbox"/> If yes, how much <u>3</u> Ft<br>Casing height above or below land surface _____ in.   | |
| <b>6 GROUT PLUG MATERIAL:</b> <input type="checkbox"/> Neat cement <input type="checkbox"/> Cement grout <input checked="" type="checkbox"/> Bentonite <input type="checkbox"/> Other _____<br>Grout Plug Intervals: From <u>3</u> ft. to <u>48.00</u> ft., From _____ ft. to _____ ft., From _____ ft. to _____ ft.<br>What is the nearest source of possible contamination:<br><div style="display: flex; justify-content: space-between;"> <div> <input type="checkbox"/> Septic tank<br/> <input checked="" type="checkbox"/> Sewer lines<br/> <input type="checkbox"/> Watertight sewer lines<br/> <input type="checkbox"/> Lateral lines<br/> <input type="checkbox"/> Cess pool         </div> <div> <input type="checkbox"/> Seepage pit<br/> <input type="checkbox"/> Pit privy<br/> <input type="checkbox"/> Sewage lagoon<br/> <input type="checkbox"/> Feedyard<br/> <input type="checkbox"/> Livestock pens         </div> <div> <input type="checkbox"/> Fuel storage<br/> <input type="checkbox"/> Fertilizer storage<br/> <input type="checkbox"/> Insecticide storage<br/> <input type="checkbox"/> Abandoned water well<br/> <input type="checkbox"/> Oil well/Gas well         </div> <div> <input type="checkbox"/> Other (specify below) _____<br/>         Direction from well? <u>North</u><br/>         How many feet? <u>50</u> </div> </div> <table border="1" style="width:100%; border-collapse: collapse; margin-top: 10px;"> <thead> <tr> <th>FROM</th> <th>TO</th> <th>PLUGGING MATERIALS</th> <th>FROM</th> <th>TO</th> <th>PLUGGING MATERIALS</th> </tr> </thead> <tbody> <tr> <td>0</td> <td>0.5</td> <td>Asphalt</td> <td></td> <td></td> <td></td> </tr> <tr> <td>0.5</td> <td>3</td> <td>Compacted silt/clay</td> <td></td> <td></td> <td></td> </tr> <tr> <td>3</td> <td>48</td> <td>Hydrated Bentonite chips</td> <td></td> <td></td> <td>U5-085-14485; Taco Johns</td> </tr> <tr><td> </td><td> </td><td> </td><td> </td><td> </td><td> </td></tr> <tr><td> </td><td> </td><td> </td><td> </td><td> </td><td> </td></tr> <tr><td> </td><td> </td><td> </td><td> </td><td> </td><td> </td></tr> <tr><td> </td><td> </td><td> </td><td> </td><td> </td><td> </td></tr> </tbody> </table> |   |   | FROM | TO | PLUGGING MATERIALS       | FROM | TO | PLUGGING MATERIALS | 0 | 0.5 | Asphalt |  |  |  | 0.5 | 3 | Compacted silt/clay |  |  |  | 3 | 48 | Hydrated Bentonite chips |  |  | U5-085-14485; Taco Johns |  |  |  |  |  |  |  |  |  |  |  |  |  |  |  |  |  |  |  |  |  |  |  |  |
| FROM   | TO   | PLUGGING MATERIALS   | FROM | TO | PLUGGING MATERIALS       | |
| 0   | 0.5   | Asphalt   | |
| 0.5   | 3   | Compacted silt/clay   | |
| 3   | 48   | Hydrated Bentonite chips   |      |    | U5-085-14485; Taco Johns | |
| |
| |
| |
| |
| <b>7 CONTRACTOR'S OR LANDOWNER'S CERTIFICATION:</b> This water well was plugged under my jurisdiction and was completed on (mo/day/year) <u>8/13/19</u> and this record is true to the best of my knowledge and belief. Kansas Water Well Contractor's License No. <u>585</u> . This Water Well Record was completed on (mo/day/year) <u>9/19/19</u> under the business name of <u>Associated Environmental, Inc.</u> by (signature) <u>[Signature]</u>   | |

Send one white copy to Kansas Department of Health & Environment, Geology Section, 1000 SW Jackson Street, Ste. 420, Topeka, KS 66612-1367. Send one copy to WATER WELL OWNER and retain one for your records.

Visit us at <http://www.kdheks.gov/waterwell/index.html> Telephone 785-296-5524.

KSA82a-1212

Revised 1/20/2015

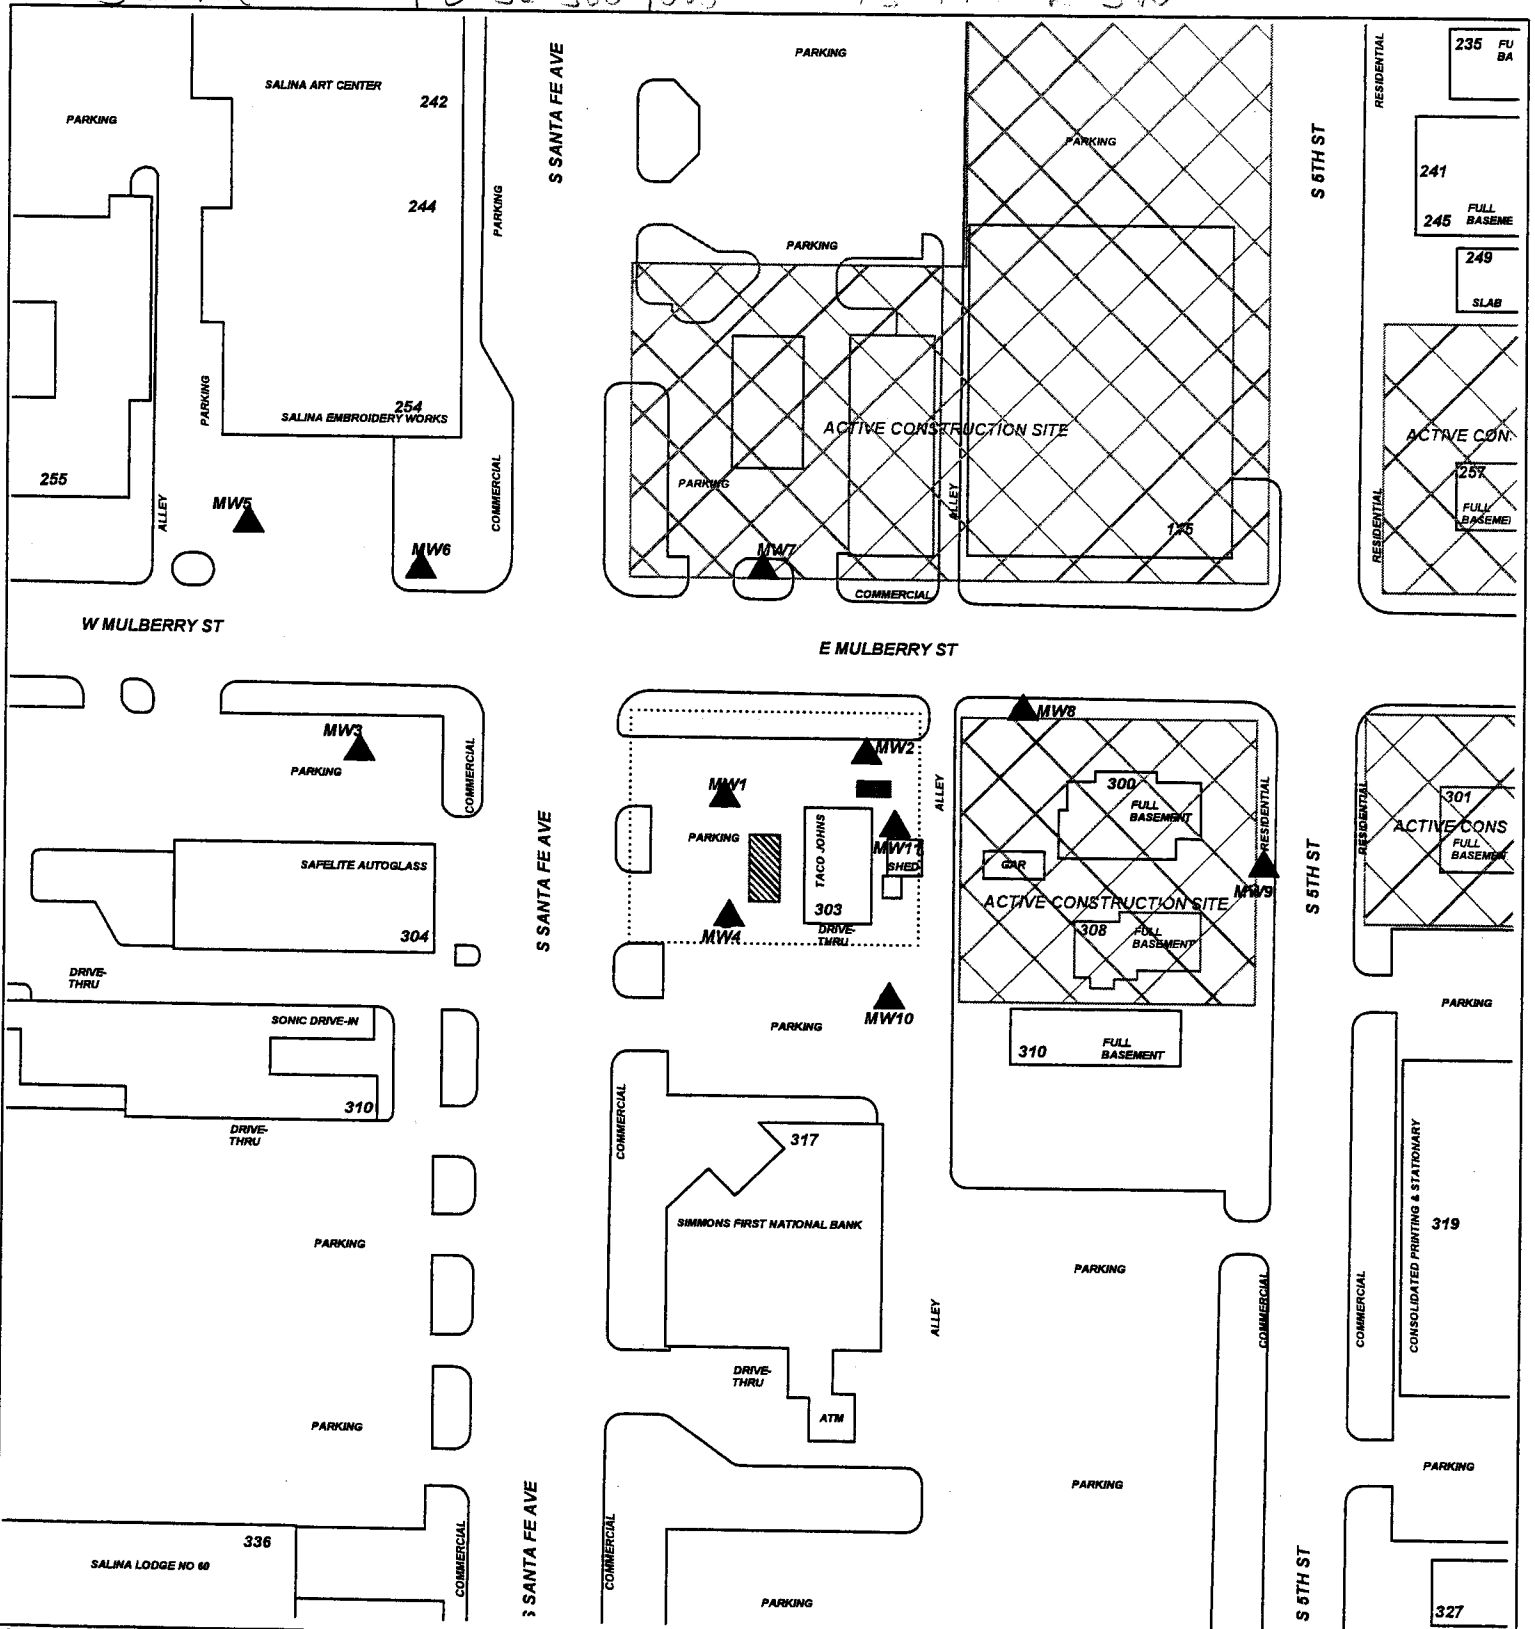

PROJECT: **TACO JOHNS**

ADDRESS: **303 S. SANTA FE**

LOCATION: **SALINA, KS**

DRAWN BY: **B. STALNAKER** DATE: **1/31/19**

REVISED BY: **B. STALNAKER** DATE: **3/26/19**


AE JOB #: **TM244** KDHE JOB #: **U5-085-14485**

TITLE:

**ASSOCIATED ENVIRONMENTAL INC.**

LEGEND:

- = FORMER UST BASIN
- = MONITORING WELL
- = PLUGGED/DESTROYED WELL
- = SUBJECT PROPERTY

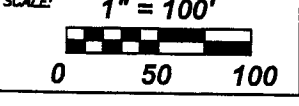

NOTES: