

WATER WELL PLUGGING RECORD Form WWC-5P

KSA 82a-1212

ID NO.

FRP-11

1 LOCATION OF WATER WELL: County: <u>Saline</u>	Fraction <u>SE 1/4 NW 1/4 SW 1/4</u>	Section Number <u>12</u>	Township Number <u>T 14 S</u>	Range Number <u>3</u> <input type="checkbox"/> E <input checked="" type="checkbox"/> W
---	---	-----------------------------	----------------------------------	---

Street/Rural Address of Well Location; if unknown, distance & direction from nearest town or intersection: If at owner's address, check here ☐ West of N. 7th Street on north side of W Pine St.

Global Positioning Systems (GPS) information:

Latitude: 38.847556 (in decimal degrees)

Longitude: -97.61047 (in decimal degrees)

Elevation:

Horizontal Datum: ☒ WGS84, ☐ NAD83, ☐ NAD27

Collection Method:


2 WATER WELL OWNER: McShares, Inc.
RR#, St. Address, Box #: 1835 E. North St.
City, State ZIP Code: Salina, Ks. 67401

☒ GPS unit (Make/Model: Android Phone)

☐ Digital Map/Photo, ☐ Topographic Map, ☐ Land Survey

Est. Accuracy: ☐ < 3 m, ☐ 3-5 m, ☐ 5-15 m, ☐ > 15 m

3 MARK WELL'S LOCATION WITH AN "X" IN SECTION BOX:

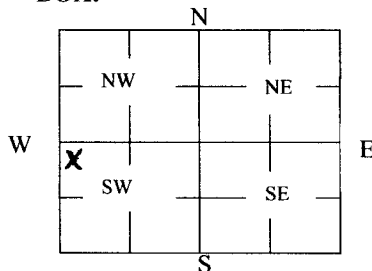

4 DEPTH OF WELL 50.3 ft.

WELL'S STATIC WATER LEVEL 24.9 ft

WELL WAS USED AS:

☐ Domestic
☐ Irrigation
☐ Feedlot
☐ Industrial

☐ Public Water Supply
☐ Oil Field Water Supply
☐ Domestic (Lawn & Garden)
☐ Air Conditioning

☐ Dewatering
☒ Monitoring
☐ Injection Well
☐ Other _____

Was a chemical/bacteriological sample submitted to Department? Yes ☐ No ☐

5 TYPE OF BLANK CASING USED:

☐ Steel
☒ PVC

☐ RMP (SR)
☐ ABS

☐ Wrought
☐ Asbestos-Cement

☐ Fiberglass
☐ Concrete Tile

☐ Other (Specify below) _____

Blank casing diameter 2 in. Was casing pulled? Yes ☒ No ☐ If yes, how much 5 ft.

Casing height above or below land surface 0 in.

6 GROUT PLUG MATERIAL: ☐ Neat cement ☐ Cement grout ☒ Bentonite ☐ Other _____

Grout Plug Intervals: From 0 ft. to 50.3 ft., From _____ ft. to _____ ft., From _____ ft. to _____ ft.

What is the nearest source of possible contamination:

☐ Septic tank
☐ Sewer lines
☐ Watertight sewer lines
☐ Lateral lines
☐ Cess pool

☐ Seepage pit
☐ Pit privy
☐ Sewage lagoon
☐ Feedyard
☐ Livestock pens

☐ Fuel storage
☐ Fertilizer storage
☐ Insecticide storage
☐ Abandoned water well
☐ Oil well/Gas well

☒ Other (specify below)
Monitoring

Direction from well? _____

How many feet? _____

FROM	TO	PLUGGING MATERIALS	FROM	TO	PLUGGING MATERIALS
0	50.3	Bentonite			

7 CONTRACTOR'S OR LANDOWNER'S CERTIFICATION: This water well was plugged under my jurisdiction and was completed on (mo/day/year) 3/26/2020 and this record is true to the best of my knowledge and belief. Kansas Water Well Contractor's License No. 604. This Water Well Record was completed on (mo/day/year) 4/14/20 under the business name of Environmental Priority Service, Inc. by (signature) [Signature]

Send one white copy to Kansas Department of Health & Environment, Geology Section, 1000 SW Jackson Street, Ste. 420, Topeka, KS 66612-1367. Send one copy to WATER WELL OWNER and retain one for your records.

Visit us at <http://www.kdheks.gov/waterwell/index.html> Telephone 785-296-5524.

KSA82a-1212


Revised 1/20/2015



Esri, HERE, Garmin, © OpenStreetMap contributors

LEGEND

- Monitor Well
- Other KDH installed Monitor Well
- Former Aboveground Storage Tank
- Potentiometric Contour (ft)
- Property Boundary
- Groundwater Elevation (ft)

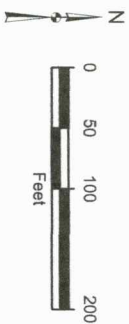

REFERENCE: Imagery from Pictometry (3/8/2017)

SCS ENGINEERS
11120 E. 26th Street North, Ste.
1100 Wichita, Kansas 67226
PH. (316) 315-4501 FAX. (316)
315-4505

**POTENTIOMETRIC SURFACE
SHALLOW WELLS**
(February 2019)

CLIENT:
MCSHARES, INC.

LOCATION: FORMER RESEARCH PRODUCTS SITE
SALINA, KS

FIGURE:
2