

WATER WELL PLUGGING RECORD Form WWC-5P

KSA 82a-1212

ID NO.

FRP

SN-1D

1 LOCATION OF WATER WELL: County: <u>Saline</u>	Fraction <u>SE 1/4 NW 1/4 NW 1/4 SW 1/4</u>	Section Number <u>12</u>	Township Number <u>T 14 S</u>	Range Number <u>3</u> <input type="checkbox"/> E <input checked="" type="checkbox"/> W
---	--	-----------------------------	----------------------------------	---

Street/Rural Address of Well Location; if unknown, distance & direction from nearest town or intersection: If at owner's address, check here ☐ West of N. 7th Street on north side of W Pine St.


Global Positioning Systems (GPS) information:

Latitude: 38.847556 (in decimal degrees)
Longitude: -97.61047 (in decimal degrees)
Elevation: _____
Horizontal Datum: ☒ WGS84, ☐ NAD83, ☐ NAD27
Collection Method: _____

2 WATER WELL OWNER: McShares, Inc.
RR#, St. Address, Box #: 1835 E. North St.
City, State ZIP Code: Salina, Ks. 67401

☒ GPS unit (Make/Model: Android Phone)
☐ Digital Map/Photo, ☐ Topographic Map, ☐ Land Survey
Est. Accuracy: ☐ < 3 m, ☐ 3-5 m, ☐ 5-15 m, ☐ > 15 m

3 MARK WELL'S LOCATION WITH AN "X" IN SECTION BOX:

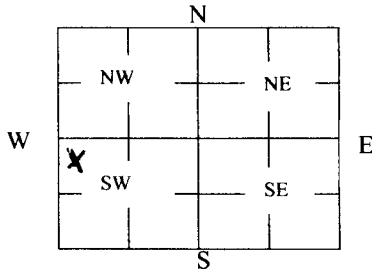

4 DEPTH OF WELL 60.1 ft.

WELL'S STATIC WATER LEVEL 25.0 ft

WELL WAS USED AS:

- | | | |
|-------------------------------------|---|--|
| <input type="checkbox"/> Domestic | <input type="checkbox"/> Public Water Supply | <input type="checkbox"/> Dewatering |
| <input type="checkbox"/> Irrigation | <input type="checkbox"/> Oil Field Water Supply | <input checked="" type="checkbox"/> Monitoring |
| <input type="checkbox"/> Feedlot | <input type="checkbox"/> Domestic (Lawn & Garden) | <input type="checkbox"/> Injection Well |
| <input type="checkbox"/> Industrial | <input type="checkbox"/> Air Conditioning | <input type="checkbox"/> Other _____ |

Was a chemical/bacteriological sample submitted to Department? Yes ☐ No ☐

5 TYPE OF BLANK CASING USED:

- ☐ Steel ☐ RMP (SR) ☐ Wrought ☐ Fiberglass ☐ Other (Specify below) _____
☒ PVC ☐ ABS ☐ Asbestos-Cement ☐ Concrete Tile

Blank casing diameter 2 in. Was casing pulled? Yes ☒ No ☐ If yes, how much 5 ft.
Casing height above or below land surface 0 in.

6 GROUT PLUG MATERIAL: ☐ Neat cement ☐ Cement grout ☒ Bentonite ☐ Other _____

Grout Plug Intervals: From 0 ft. to 60.1 ft., From _____ ft. to _____ ft., From _____ ft. to _____ ft.

What is the nearest source of possible contamination:

- | | | | |
|---|---|---|---|
| <input type="checkbox"/> Septic tank | <input type="checkbox"/> Seepage pit | <input type="checkbox"/> Fuel storage | <input checked="" type="checkbox"/> Other (specify below) |
| <input type="checkbox"/> Sewer lines | <input type="checkbox"/> Pit privy | <input type="checkbox"/> Fertilizer storage | <input checked="" type="checkbox"/> Monitoring |
| <input type="checkbox"/> Watertight sewer lines | <input type="checkbox"/> Sewage lagoon | <input type="checkbox"/> Insecticide storage | |
| <input type="checkbox"/> Lateral lines | <input type="checkbox"/> Feedyard | <input type="checkbox"/> Abandoned water well | Direction from well? _____ |
| <input type="checkbox"/> Cess pool | <input type="checkbox"/> Livestock pens | <input type="checkbox"/> Oil well/Gas well | How many feet? _____ |

FROM	TO	PLUGGING MATERIALS	FROM	TO	PLUGGING MATERIALS
0	60.1	Bentonite			

7 CONTRACTOR'S OR LANDOWNER'S CERTIFICATION: This water well was plugged under my jurisdiction and was completed on (mo/day/year) 3/26/2020 and this record is true to the best of my knowledge and belief. Kansas Water Well Contractor's License No. 604. This Water Well Record was completed on (mo/day/year) 4/17/20 under the business name of Environmental Priority Service, Inc. by (signature) [Signature]

Send one white copy to Kansas Department of Health & Environment, Geology Section, 1000 SW Jackson Street, Ste. 420, Topeka, KS 66612-1367. Send one copy to WATER WELL OWNER and retain one for your records.
Visit us at <http://www.kdheks.gov/waterwell/index.html> Telephone 785-296-5524.

KSA82a-1212


Revised 1/20/2015



Esri, HERE, Garmin, © OpenStreetMap contributors

LEGEND

- Monitor Well
- Other KDH installed Monitor Well
- Former Aboveground Storage Tank
- Potentiometric Contour (ft)
- Property Boundary
- Groundwater Elevation (ft)

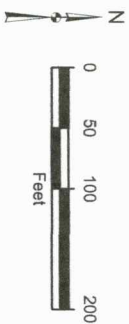

REFERENCE: Imagery from Pictometry (3/8/2017)

SCS ENGINEERS
11120 E. 26th Street North, Ste.
1100 Wichita, Kansas 67226
PH. (316) 315-4501 FAX. (316)
315-4505

**POTENTIOMETRIC SURFACE
SHALLOW WELLS**
(February 2019)

CLIENT: MCSHARES, INC.

LOCATION: FORMER RESEARCH PRODUCTS SITE
SALINA, KS

FIGURE: 2