

**WATER WELL PLUGGING RECORD Form WWC-5P KSA 82a-1212 ID NO.**

SN-3D


<b>1 LOCATION OF WATER WELL:</b> County: <u>Saline</u>	Fraction <u>SE ¼ NW¼ NW ¼ SW ¼</u>	Section Number <u>12</u>	Township Number <u>T 14 S</u>	Range Number <u>3</u> <input type="checkbox"/> E <input checked="" type="checkbox"/> W
---	---------------------------------------	-----------------------------	----------------------------------	---

Street/Rural Address of Well Location; if unknown, distance & direction from nearest town or intersection: If at owner's address, check here  South of railroad tracks west of N. 7th Street

**Global Positioning Systems (GPS) information:**  
 Latitude: 38.847782 (in decimal degrees)  
 Longitude: -97.610793 (in decimal degrees)  
 Elevation: \_\_\_\_\_  
 Horizontal Datum:  WGS84,  NAD83,  NAD27  
 Collection Method: \_\_\_\_\_

**2 WATER WELL OWNER:** McShares, Inc.  
 RR#, St. Address, Box #: 1835 E. North St.  
 City, State ZIP Code: Salina, Ks. 67401

GPS unit (Make/Model: Android Phone)  
 Digital Map/Photo,  Topographic Map,  Land Survey  
 Est. Accuracy:  < 3 m,  3-5 m,  5-15 m,  > 15 m

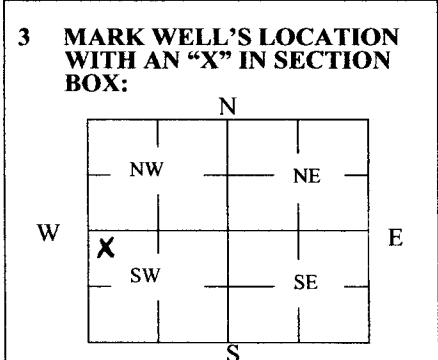

**4 DEPTH OF WELL** 61.2 ft.  
 WELL'S STATIC WATER LEVEL 24.1 ft.  
 WELL WAS USED AS:  
 Domestic  Public Water Supply  Dewatering  
 Irrigation  Oil Field Water Supply  Monitoring  
 Feedlot  Domestic (Lawn & Garden)  Injection Well  
 Industrial  Air Conditioning  Other \_\_\_\_\_  
 Was a chemical/bacteriological sample submitted to Department? Yes  No

**5 TYPE OF BLANK CASING USED:**

Steel  RMP (SR)  Wrought  Fiberglass  Other (Specify below) \_\_\_\_\_  
 PVC  ABS  Asbestos-Cement  Concrete Tile

Blank casing diameter 2 in. Was casing pulled? Yes  No  If yes, how much 5 ft.  
 Casing height above or below land surface 0 in.

**6 GROUT PLUG MATERIAL:**  Neat cement  Cement grout  Bentonite  Other \_\_\_\_\_

Grout Plug Intervals: From 0 ft. to 61.2 ft., From \_\_\_\_\_ ft. to \_\_\_\_\_ ft., From \_\_\_\_\_ ft. to \_\_\_\_\_ ft.

What is the nearest source of possible contamination:  
 Septic tank  Seepage pit  Fuel storage  Other (specify below) Monitoring  
 Sewer lines  Pit privy  Fertilizer storage  
 Watertight sewer lines  Sewage lagoon  Insecticide storage  
 Lateral lines  Feedyard  Abandoned water well Direction from well? \_\_\_\_\_  
 Cess pool  Livestock pens  Oil well/Gas well How many feet? \_\_\_\_\_

FROM	TO	PLUGGING MATERIALS	FROM	TO	PLUGGING MATERIALS
0	61.2	Bentonite			

**7 CONTRACTOR'S OR LANDOWNER'S CERTIFICATION:** This water well was plugged under my jurisdiction and was completed on (mo/day/year) 3/26/2020 and this record is true to the best of my knowledge and belief. Kansas Water Well Contractor's License No. 604. This Water Well Record was completed on (mo/day/year) 4/14/20 under the business name of Environmental Priority Service, Inc. by (signature) [Signature]


Send one white copy to Kansas Department of Health & Environment, Geology Section, 1000 SW Jackson Street, Ste. 420, Topeka, KS 66612-1367. Send one copy to WATER WELL OWNER and retain one for your records.  
 Visit us at <http://www.kdheks.gov/waterwell/index.html> Telephone 785-296-5524.



Esri, HERE, Garmin, © OpenStreetMap contributors

**LEGEND**

- Monitor Well
- Other KDHE Installed Monitor Well
- Former Aboveground Storage Tank
- Potentiometric Contour (ft)
- Property Boundary
- (1190.50) Groundwater Elevation (ft)

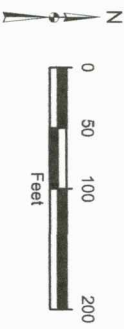

REFERENCE: Imagery from Pictometry (3/8/2017)

**SCS ENGINEERS**  
 11120 E. 26th Street North, Ste. 1100  
 Wichita, Kansas 67226  
 PH. (316) 315-4501 FAX. (316) 315-4505

**POTENTIOMETRIC SURFACE SHALLOW WELLS**  
 (February 2019)

CLIENT: MCSHARES, INC.

LOCATION: FORMER RESEARCH PRODUCTS SITE  
 SALINA, KS

FIGURE: 2