

WATER WELL PLUGGING RECORD Form WWC-5P

KSA 82a-1212 ID NO.

GWS

1 LOCATION OF WATER WELL: County: <u>Saline</u>	Fraction <u>SE 1/4 NW 1/4 SW 1/4</u>	Section Number <u>12</u>	Township Number <u>T 14 S</u>	Range Number <u>3</u> <input type="checkbox"/> E <input checked="" type="checkbox"/> W
---	---	-----------------------------	----------------------------------	---

Street/Rural Address of Well Location; if unknown, distance & direction from nearest town or intersection: If at owner's address, check here South of railroad tracks west of N. 7th Street

Global Positioning Systems (GPS) information:
 Latitude: 38.847777 (in decimal degrees)
 Longitude: -97.61077 (in decimal degrees)
 Elevation:
 Horizontal Datum: WGS84, NAD83, NAD27
 Collection Method:

2 WATER WELL OWNER: McShares, Inc.
 RR#, St. Address, Box #: 1835 E. North St.
 City, State ZIP Code: Salina, Ks. 67401

GPS unit (Make/Model: Android Phone)
 Digital Map/Photo, Topographic Map, Land Survey
 Est. Accuracy: < 3 m, 3-5 m, 5-15 m, > 15 m

3 MARK WELL'S LOCATION WITH AN "X" IN SECTION BOX:

4 DEPTH OF WELL 37.4 ft.
 WELL'S STATIC WATER LEVEL 24.05 ft.
 WELL WAS USED AS:

<input type="checkbox"/> Domestic	<input type="checkbox"/> Public Water Supply	<input type="checkbox"/> Dewatering
<input type="checkbox"/> Irrigation	<input type="checkbox"/> Oil Field Water Supply	<input type="checkbox"/> Monitoring
<input type="checkbox"/> Feedlot	<input type="checkbox"/> Domestic (Lawn & Garden)	<input type="checkbox"/> Injection Well
<input type="checkbox"/> Industrial	<input type="checkbox"/> Air Conditioning	<input checked="" type="checkbox"/> Other _____

Was a chemical/bacteriological sample submitted to Department? Yes No

5 TYPE OF BLANK CASING USED:

<input type="checkbox"/> Steel	<input type="checkbox"/> RMP (SR)	<input type="checkbox"/> Wrought	<input type="checkbox"/> Fiberglass	<input type="checkbox"/> Other (Specify below)
<input checked="" type="checkbox"/> PVC	<input type="checkbox"/> ABS	<input type="checkbox"/> Asbestos-Cement	<input type="checkbox"/> Concrete Tile	

Blank casing diameter 2 in. Was casing pulled? Yes No If yes, how much 5 ft.
 Casing height above or below land surface 0 in.

6 GROUT PLUG MATERIAL: Neat cement Cement grout Bentonite Other _____

Grout Plug Intervals: From 0 ft. to 37.4 ft., From _____ ft. to _____ ft., From _____ ft. to _____ ft.

What is the nearest source of possible contamination:

<input type="checkbox"/> Septic tank	<input type="checkbox"/> Seepage pit	<input type="checkbox"/> Fuel storage	<input checked="" type="checkbox"/> Other (specify below)
<input type="checkbox"/> Sewer lines	<input type="checkbox"/> Pit privy	<input type="checkbox"/> Fertilizer storage	<u>Monitoring</u>
<input type="checkbox"/> Watertight sewer lines	<input type="checkbox"/> Sewage lagoon	<input type="checkbox"/> Insecticide storage	
<input type="checkbox"/> Lateral lines	<input type="checkbox"/> Feedyard	<input type="checkbox"/> Abandoned water well	Direction from well? _____
<input type="checkbox"/> Cess pool	<input type="checkbox"/> Livestock pens	<input type="checkbox"/> Oil well/Gas well	How many feet? _____

FROM	TO	PLUGGING MATERIALS	FROM	TO	PLUGGING MATERIALS
0	37.4	Bentonite			


7 CONTRACTOR'S OR LANDOWNER'S CERTIFICATION: This water well was plugged under my jurisdiction and was completed on (mo/day/year) 3/26/2020 and this record is true to the best of my knowledge and belief. Kansas Water Well Contractor's License No. 604. This Water Well Record was completed on (mo/day/year) 4/19/20 under the business name of Environmental Priority Service, Inc. by (signature) [Signature]

Send one white copy to Kansas Department of Health & Environment, Geology Section, 1000 SW Jackson Street, Ste. 420, Topeka, KS 66612-1367. Send one copy to WATER WELL OWNER and retain one for your records.
 Visit us at <http://www.kdheks.gov/waterwell/index.html> Telephone 785-296-5524.



Esri, HERE, Garmin, © OpenStreetMap contributors

<p>LEGEND</p> <ul style="list-style-type: none"> Monitor Well Other KDHE Installed Monitor Well Former Aboveground Storage Tank Potentiometric Contour (ft) Property Boundary (1190.50) Groundwater Elevation (ft) 	
<p>SCS ENGINEERS 11120 E. 26th Street North, Ste. 1100 Wichita, Kansas 67226 PH. (316) 315-4501 FAX. (316) 315-4505</p>	
<p>POTENTIOMETRIC SURFACE SHALLOW WELLS (February 2019)</p>	
<p>CLIENT: MCSHARES, INC.</p>	<p>LOCATION: FORMER RESEARCH PRODUCTS SITE SALINA, KS</p>
<p>FIGURE: 2</p>	

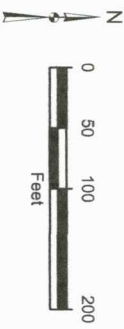

REFERENCE: Imagery from Pictometry (3/9/2017)