

WATER WELL PLUGGING RECORD Form WWC-5P

KSA 82a-1212 ID NO.

Well #4 Discharge

1 LOCATION OF WATER WELL: Fraction W4 1/4 NW 1/4 NE 1/4 NE 1/4 Section Number 26 Township Number T 14 S Range Number 3 ☐ E ☒ W
 County: Saline

Street/Rural Address of Well Location; if unknown, distance & direction from nearest town or intersection: If at owner's address, check here ☒


Global Positioning Systems (GPS) information:

Latitude: 38.812250 (in decimal degrees)
 Longitude: -97.618310 (in decimal degrees)
 Elevation: 1238.00
 Datum: ☒ WGS84, ☐ NAD83, ☐ NAD27
 Collection Method:

2 WATER WELL OWNER: USD 305
 RR#, St. Address, Box #: 1835 S. Broadway Blvd.
 City, State ZIP Code: Salina, KS 67401

☐ GPS unit (Make/Model: _____)
☒ Digital Map/Photo, ☐ Topographic Map, ☐ Land Survey
 Est. Accuracy: ☒ < 3 m, ☐ 3-5 m, ☐ 5-15 m, ☐ > 15 m

3 MARK WELL'S LOCATION WITH AN "X" IN SECTION BOX:

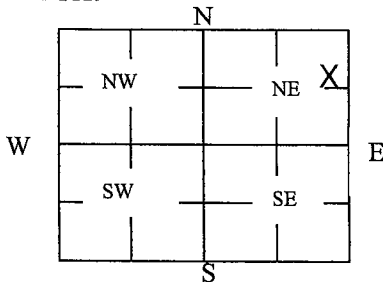

4 DEPTH OF WELL 60.00' ft.

WELL'S STATIC WATER LEVEL 32 ft

WELL WAS USED AS:

☐ Domestic ☐ Public Water Supply ☐ Dewatering
☐ Irrigation ☐ Oil Field Water Supply ☐ Monitoring
☐ Feedlot ☐ Domestic (Lawn & Garden) ☐ Injection Well
☐ Industrial ☐ Air Conditioning ☒ Other Disposal Well

Was a chemical/bacteriological sample submitted to Department? Yes ☐ No ☒

5 TYPE OF BLANK CASING USED:

☐ Steel ☐ RMP (SR) ☐ Wrought ☐ Fiberglass ☐ Other (Specify below)
☒ PVC ☐ ABS ☐ Asbestos-Cement ☐ Concrete Tile

Blank casing diameter 8 in. Was casing pulled? Yes ☒ No ☐ If yes, how much 3.00'
 Casing height above or below land surface -36 in.

6 GROUT PLUG MATERIAL: ☐ Neat cement ☐ Cement grout ☐ Bentonite ☒ Other Bentonite Cement Mix

Grout Plug Intervals: From 3 ft. to 13 ft., From 26.5 ft. to 26.5 ft., From _____ ft. to _____ ft., From _____ to _____ ft.

What is the nearest source of possible contamination:

☐ Septic tank ☐ Seepage pit ☐ Fuel Storage ☐ Other (specify below)
☒ Sewer lines ☐ Pit privy ☐ Fertilizer storage
☐ Watertight sewer lines ☐ Sewage lagoon ☐ Insecticide storage
☐ Lateral lines ☐ Feedyard ☐ Abandoned water well Direction from well? North East
☐ Cess pool ☐ Livestock pens ☐ Oil well/Gas well How many feet? 200.00'

FROM	TO	PLUGGING MATERIALS	FROM	TO	PLUGGING MATERIALS
60	43	Granular Fill (Pea Gravel)			
43	26.50	Sand, fine to medium			
26.50	3	Bentoite Cement Mix			
3	0	Top Soil			

7 CONTRACTOR'S OR LANDOWNER'S CERTIFICATION: This water well was plugged under my jurisdiction and was completed on (mo/day/year) 04/20/22 and this record is true to the best of my knowledge and belief. Kansas Water Well Contractor's License No. _____. This Water Well Record was completed on (mo/day/year) 05/19/22 under the business name of Nelson-Fowels, LLC by (signature) Tyler Neufeld

INSTRUCTIONS: Use typewriter or ballpoint pen. Please press firmly and print clearly. Please fill in blanks, underline or circle the correct answers. Send top three copies to Kansas Department of Health and Environment, Bureau of Water, Geology Section, 1000 SW Jackson St., Ste. 420, Topeka, Kansas 66612-1367. Telephone: 785/296-5524. Send one to Water Well Owner and retain one for your records. Visit us at <http://www.kdheks.gov/waterwell/index.html>.

Check one: ☐ White Copy ☐ Blue Copy ☐ Pink Copy