

**WATER WELL RECORD Form WWC-5**

Division of Water Resources App. No.

Well ID MW-7

Original Record  Correction  Change in Well Use

<b>1 LOCATION OF WATER WELL:</b> County: <b>Salina</b>	Fraction NW ¼ NW ¼ NW ¼ NE ¼	Section Number <b>15</b>	Township Number <b>T 14 S</b>	Range Number <b>R 3</b> <input type="checkbox"/> E <input checked="" type="checkbox"/> W
---	---------------------------------	-----------------------------	----------------------------------	---

<b>2 WELL OWNER:</b> Last Name: <b>NuStar Energy</b> Business: <b>NuStar Energy</b> Address: <b>2137 W Old Hwy 40</b> Address: City: <b>Salina</b> State: <b>KS</b> ZIP: <b>67401</b>	Street or Rural Address where well is located (if unknown, distance and direction from nearest town or intersection): If at owner's address, check here: <input checked="" type="checkbox"/> <b>East of intersection of Hwy 40 and I-135, Salina, KS.</b>
---	--

<b>3 LOCATE WELL WITH "X" IN SECTION BOX:</b> 	<b>4 DEPTH OF COMPLETED WELL:</b> ..... <b>28</b> ..... ft. Depth(s) Groundwater Encountered: 1) ..... <b>24.5</b> ..... ft. 2) ..... ft. 3) ..... ft., or 4) <input type="checkbox"/> Dry Well WELL'S STATIC WATER LEVEL: ..... <b>3.2</b> ..... ft. <input checked="" type="checkbox"/> below land surface, measured on (mo-day-yr) ..... <b>6-3-2022</b> ..... <input type="checkbox"/> above land surface, measured on (mo-day-yr) ..... Pump test data: Well water was ..... ft. after ..... hours pumping ..... gpm Well water was ..... ft. after ..... hours pumping ..... gpm Estimated Yield: ..... <b>8.75</b> ..... gpm Bore Hole Diameter: ..... <b>28</b> ..... in. to ..... ft. and ..... in. to ..... ft.	<b>5 Latitude:</b> ..... <b>38.84</b> ..... <b>11.2</b> ..... (decimal degrees) <b>Longitude:</b> ..... <b>-97.64000</b> ..... (decimal degrees) Horizontal Datum: <input checked="" type="checkbox"/> WGS 84 <input type="checkbox"/> NAD 83 <input type="checkbox"/> NAD 27 Source for Latitude/Longitude: <input type="checkbox"/> GPS (unit make/model: .....) (WAAS enabled? <input type="checkbox"/> Yes <input type="checkbox"/> No) <input type="checkbox"/> Land Survey <input type="checkbox"/> Topographic Map <input checked="" type="checkbox"/> Online Mapper: <b>Google Earth</b>
<b>6 Elevation:</b> <b>1224.72</b> ..... ft. <input type="checkbox"/> Ground Level <input checked="" type="checkbox"/> TOC Source: <input checked="" type="checkbox"/> Land Survey <input type="checkbox"/> GPS <input type="checkbox"/> Topographic Map <input type="checkbox"/> Other .....		

**7 WELL WATER TO BE USED AS:**

1. Domestic: <input type="checkbox"/> Household <input type="checkbox"/> Lawn & Garden <input type="checkbox"/> Livestock 2. <input type="checkbox"/> Irrigation 3. <input type="checkbox"/> Feedlot 4. <input type="checkbox"/> Industrial	5. <input type="checkbox"/> Public Water Supply: well ID ..... 6. <input type="checkbox"/> Dewatering: how many wells? ..... 7. <input type="checkbox"/> Aquifer Recharge: well ID ..... 8. <input checked="" type="checkbox"/> Monitoring: well ID <b>MW-7</b> ..... 9. Environmental Remediation: well ID ..... <input type="checkbox"/> Air Sparge <input type="checkbox"/> Soil Vapor Extraction <input type="checkbox"/> Recovery <input type="checkbox"/> Injection	10. <input type="checkbox"/> Oil Field Water Supply: lease ..... 11. Test Hole: well ID ..... <input type="checkbox"/> Cased <input type="checkbox"/> Uncased <input type="checkbox"/> Geotechnical 12. Geothermal: how many bores? ..... a) Closed Loop <input type="checkbox"/> Horizontal <input type="checkbox"/> Vertical b) Open Loop <input type="checkbox"/> Surface Discharge <input type="checkbox"/> Inj. of Water 13. <input type="checkbox"/> Other (specify): .....
---	---	---

**Was a chemical/bacteriological sample submitted to KDHE?**  Yes  No If yes, date sample was submitted: .....

Water well disinfected?  Yes  No

**8 TYPE OF CASING USED:**  Steel  PVC  Other ..... CASING JOINTS:  Glued  Clamped  Welded  Threaded  
 Casing diameter ..... **2** ..... in. to ..... **18** ..... ft., Diameter ..... in. to ..... ft., Diameter ..... in. to ..... ft.  
 Casing height above land surface ..... in. Weight ..... lbs./ft. Wall thickness or gauge No. **sch 40**

**TYPE OF SCREEN OR PERFORATION MATERIAL:**  
 Steel  Stainless Steel  Fiberglass  PVC  Other (Specify) .....  
 Brass  Galvanized Steel  Concrete tile  None used (open hole)

**SCREEN OR PERFORATION OPENINGS ARE:**  
 Continuous Slot  Mill Slot  Gauze Wrapped  Torch Cut  Drilled Holes  Other (Specify) .....  
 Louvered Shutter  Key Punched  Wire Wrapped  Saw Cut  None (Open Hole)

**SCREEN-PERFORATED INTERVALS:** From **18** ..... ft. to **28** ..... ft., From ..... ft. to ..... ft., From ..... ft. to ..... ft.  
**GRAVEL PACK INTERVALS:** From **16** ..... ft. to **28** ..... ft., From ..... ft. to ..... ft., From ..... ft. to ..... ft.

**9 GROUT MATERIAL:**  Neat cement  Cement grout  Bentonite  Other **cement pad**  
 Grout Intervals: From ..... ft. to **16** ..... ft., From ..... ft. to ..... ft., From ..... ft. to ..... ft.

**Nearest source of possible contamination:**

<input type="checkbox"/> Septic Tank	<input type="checkbox"/> Lateral Lines	<input type="checkbox"/> Pit Privy	<input type="checkbox"/> Livestock Pens	<input type="checkbox"/> Insecticide Storage
<input type="checkbox"/> Sewer Lines	<input type="checkbox"/> Cess Pool	<input type="checkbox"/> Sewage Lagoon	<input checked="" type="checkbox"/> Fuel Storage	<input type="checkbox"/> Abandoned Water Well
<input type="checkbox"/> Watertight Sewer Lines	<input type="checkbox"/> Seepage Pit	<input type="checkbox"/> Feedyard	<input type="checkbox"/> Fertilizer Storage	<input type="checkbox"/> Oil Well/Gas Well
<input type="checkbox"/> Other (Specify) .....				

Direction from well? **north west** ..... Distance from well? **150** ..... ft.

10 FROM	TO	LITHOLOGIC LOG	FROM	TO	LITHO. LOG (cont.) or PLUGGING INTERVALS
0	0.5	Topsoil, brown			
0.5	5.5	Clay, brown, dark brown mottling, dry, stiff			
5.5	7.5	Clay, light gray brown, dry			
7.5	21.5	Clay, gray, dark brown mottling, moist, plastic			
21.5	25	Clay, tan, gray brown mottling, moist			
25	27.5	Sandy Clay, orange brown, wet			Notes:
27.5	28	Clayey Sand, gray, wet			

**11 CONTRACTOR'S OR LANDOWNER'S CERTIFICATION:** This water well was  constructed,  reconstructed, or  plugged under my jurisdiction and was completed on (mo-day-year) **6/2/2022** ..... and this record is true to the best of my knowledge and belief. Kansas Water Well Contractor's License No. **604** ..... This Water Well Record was completed on (mo-day-year) **6/30/22** ..... under the business name of **Environmental Priority Service, Inc.** Signature **J. A. H.**

Mail 1 white copy along with a fee of \$5.00 for each constructed well to: Kansas Department of Health and Environment, Bureau of Water, GWTS Section, 1000 SW Jackson St., Suite 420, Topeka, Kansas 66612-1367. Mail one to Water Well Owner and retain one for your records. Telephone 785-296-5524. Visit us at <http://www.kdheks.gov/waterwell/index.html> KSA 82a-1212



**Garber Surveying Service, P.A.**

**Monitoring Well Survey**

**Client: Braun Intertec**

**Location: Salina Terminal, Salina, KS**

**(NW 1/4 Section 7, Township 6 South, Range 3 East of the 6th P.M.)**

<b>Monitoring Well Number</b>	<b>SPCS Northing</b>	<b>SPCS Easting</b>	<b>Elevation</b>	<b>Description</b>
F-R3	185234.80	1414809.95	1224.77	North Rim PVC Casing
			1225.15	Ground
MW-4R	184998.83	1414150.38	1231.10	North Rim PVC Casing
			1231.18	Ground
MW-7	185143.20	1414872.96	1224.72	North Rim PVC Casing
			1225.15	Ground

<b>CP/BM Number</b>	<b>SPCS Northing</b>	<b>SPCS Easting</b>	<b>Elevation</b>	<b>Description</b>
10	185172.31	1414793.35	1228.08	Sq. Cut on SW corner of light pole, 2nd West of East Fence

**SURVEY NOTES:**


- 1) The above survey data was collected on 6/2/2022
- 2) The above coordinate and elevation data is shown in NAD 83(2011) Kansas State Plane Kansas North Zone (SPCS), NAVD88 vertical datum

**SURVEYOR'S CERTIFICATE:**

I hereby certify the above data to be a true and correct representation of the elevations and location of the monitoring wells, as surveyed under my supervision, this 10th day of June, 2022.

\_\_\_\_\_  
Nicholas D. Schmidt, PS #1492



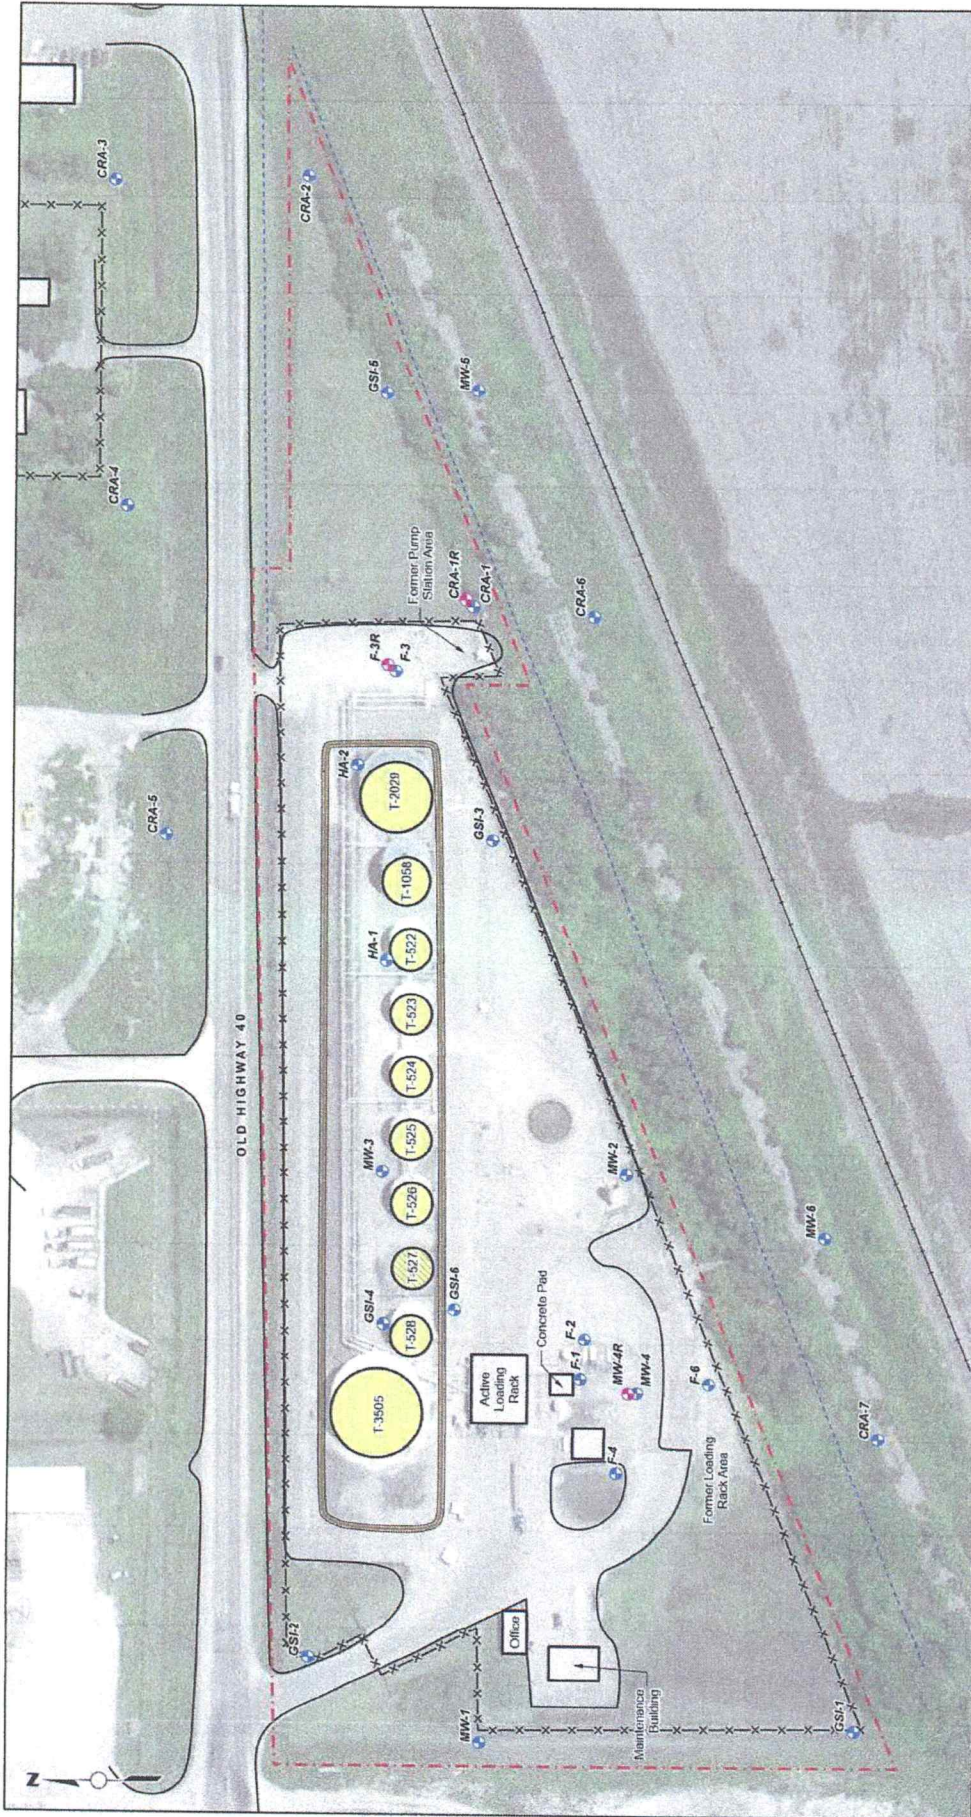

Source: APEX Site Plan (Nov-2018); Google Earth Imagery

**Figure 1**  
**Proposed Monitoring Wells**  
 Salina Terminal  
 Salina, Kansas



**Legend**

	Approximate Site Boundary		Monitoring Well		Railroad
	Building		Proposed Monitoring Well		Fence/line
	Tank		Enriched Berm		Drainage Ditch
	Former Tank				

3/16/2022 Project No.: 82004272.00 Drawn by: SL Checked by: SG Revised by: