

# WATER WELL PLUGGING RECORD Form WWC-5P

KSA 82a-1212

ID NO.

AS-7

|                                                           |                                     |                            |                                  |                                                                                           |
|-----------------------------------------------------------|-------------------------------------|----------------------------|----------------------------------|-------------------------------------------------------------------------------------------|
| <b>1 LOCATION OF WATER WELL:</b><br>County: <u>Saline</u> | Fraction<br><u>¼ SW ¼ SW ¼ SW ¼</u> | Section Number<br><u>1</u> | Township Number<br><u>T 14 S</u> | Range Number<br><u>3</u> <input type="checkbox"/> E <input checked="" type="checkbox"/> W |
|-----------------------------------------------------------|-------------------------------------|----------------------------|----------------------------------|-------------------------------------------------------------------------------------------|

Street/Rural Address of Well Location; if unknown, distance & direction from nearest town or intersection: If at owner's address, check here ☐ 900 N. 9th, Salina, KS

KDHE Project # U5-085-10100

## Global Positioning Systems (GPS) information:

Latitude: 38.85639 (in decimal degrees)

Longitude: -97.61228 (in decimal degrees)

Elevation:

Horizontal Datum: ☐ WGS84, ☐ NAD83, ☐ NAD27

Collection Method:


☐ GPS unit (Make/Model: \_\_\_\_\_)

☐ Digital Map/Photo, ☐ Topographic Map, ☒ Land Survey

Est. Accuracy: ☐ < 3 m, ☐ 3-5 m, ☐ 5-15 m, ☐ > 15 m

**2 WATER WELL OWNER:** Reimold Properties, Inc.  
RR#, St. Address, Box #: PO Box 1302  
City, State ZIP Code: Salina, KS 67402

## 3 MARK WELL'S LOCATION WITH AN "X" IN SECTION BOX:

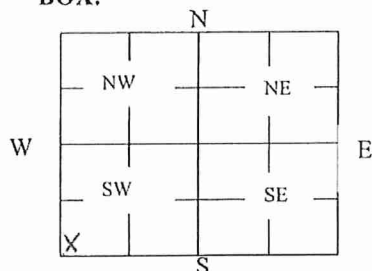

## 4 DEPTH OF WELL 36 ft.

WELL'S STATIC WATER LEVEL NA ft

WELL WAS USED AS:

☐ Domestic  
☐ Irrigation  
☐ Feedlot  
☐ Industrial

☐ Public Water Supply  
☐ Oil Field Water Supply  
☐ Domestic (Lawn & Garden)  
☐ Air Conditioning

☐ Dewatering  
☐ Monitoring  
☐ Injection Well  
☒ Other Air Sparge

Was a chemical/bacteriological sample submitted to Department? Yes ☐ No ☐

## 5 TYPE OF BLANK CASING USED:

☐ Steel  
☒ PVC

☐ RMP (SR)  
☐ ABS

☐ Wrought  
☐ Asbestos-Cement

☐ Fiberglass  
☐ Concrete Tile

☐ Other (Specify below) \_\_\_\_\_

Blank casing diameter 2 in. Was casing pulled? Yes ☒ No ☐ If yes, how much ~3ft below ground surface  
Casing height above or below land surface -36 in.

## 6 GROUT PLUG MATERIAL:

☐ Neat cement

☐ Cement grout

☒ Bentonite

☐ Other \_\_\_\_\_

Grout Plug Intervals: From 3 ft. to 36 ft., From \_\_\_\_\_ ft. to \_\_\_\_\_ ft., From \_\_\_\_\_ ft. to \_\_\_\_\_ ft.

What is the nearest source of possible contamination:

☐ Septic tank  
☐ Sewer lines  
☐ Watertight sewer lines  
☐ Lateral lines  
☐ Cess pool

☐ Seepage pit  
☐ Pit privy  
☐ Sewage lagoon  
☐ Feedyard  
☐ Livestock pens

☐ Fuel storage  
☐ Fertilizer storage  
☐ Insecticide storage  
☐ Abandoned water well  
☐ Oil well/Gas well

☐ Other (specify below) \_\_\_\_\_

Direction from well? \_\_\_\_\_  
How many feet? \_\_\_\_\_

| FROM | TO | PLUGGING MATERIALS | FROM | TO | PLUGGING MATERIALS |
|------|----|--------------------|------|----|--------------------|
| 3    | 36 | Bentonite          |      |    | RECEIVED           |
|      |    |                    |      |    | JUN 02 2025        |
|      |    |                    |      |    | BUREAU OF WATER    |
|      |    |                    |      |    |                    |
|      |    |                    |      |    |                    |
|      |    |                    |      |    |                    |
|      |    |                    |      |    |                    |

**7 CONTRACTOR'S OR LANDOWNER'S CERTIFICATION:** This water well was plugged under my jurisdiction and was completed on (mo/day/year) 5/22/25 and this record is true to the best of my knowledge and belief. Kansas Water Well Contractor's License No. NA. This Water Well Record was completed on (mo/day/year) 05/27/2025 under the business name of GreenField Contractors, Inc. by (signature) Melissa D. Melville

Send one white copy to Kansas Department of Health & Environment, Geology Section, 1000 SW Jackson Street, Ste. 420, Topeka, KS 66612-1367. Send one copy to WATER WELL OWNER and retain one for your records.  
Visit us at <http://www.kdheks.gov/waterwell/index.html> Telephone 785-296-5524.

KSA82a-1212

Revised 1/20/2015