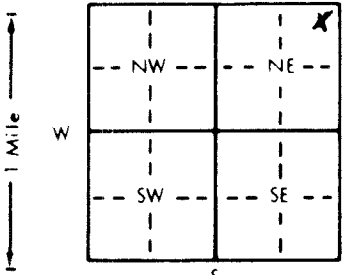


1 LOCATION OF WATER WELL: County: <u>Saline</u>		Fraction <u>NE 1/4 NE 1/4 NE 1/4</u>		Section Number <u>2</u>	Township Number <u>T 14 S</u>	Range Number <u>R 3</u> EW	
Distance and direction from nearest town or city street address of well if located within city? <u>1745 N 9th, Salina, Ks.</u> MW 1	
2 WATER WELL OWNER: <u>C.L. Clark</u> RR#, St. Address, Box #: <u>129 S 8th</u> City, State, ZIP Code: <u>Salina, Ks. 67401</u> <div style="text-align:right">Board of Agriculture, Division of Water Resources Application Number:</div>	
3 LOCATE WELL'S LOCATION WITH AN "X" IN SECTION BOX: <div style="text-align:center;"></div>		4 DEPTH OF COMPLETED WELL <u>35</u> ft. ELEVATION: _____ ft. Depth(s) Groundwater Encountered 1. _____ ft. 2. _____ ft. 3. _____ ft. WELL'S STATIC WATER LEVEL <u>30.60</u> ft. below land surface measured on mo/day/yr <u>8-21-91</u> Pump test data: Well water was _____ ft. after _____ hours pumping _____ gpm Est. Yield _____ gpm: Well water was _____ ft. after _____ hours pumping _____ gpm Bore Hole Diameter <u>7 5/8</u> in. to <u>35</u> ft. and _____ in. to _____ ft. WELL WATER TO BE USED AS: 5 Public water supply 8 Air conditioning 11 Injection well 1 Domestic 3 Feedlot 6 Oil field water supply 9 Dewatering 12 Other (Specify below) 2 Irrigation 4 Industrial 7 Lawn and garden only <u>10 Monitoring well</u> Was a chemical/bacteriological sample submitted to Department? Yes _____ No <u>X</u> If yes, mo/day/yr sample was submitted _____ Water Well Disinfected? Yes _____ No <u>X</u>	
5 TYPE OF BLANK CASING USED: 1 Steel 3 RMP (SR) 5 Wrought iron 8 Concrete tile CASING JOINTS: Glued _____ Clamped _____ <u>2 PVC</u> 4 ABS 6 Asbestos-Cement 9 Other (specify below) Welded _____ 7 Fiberglass _____ Threaded <u>✓</u> Blank casing diameter <u>2</u> in. to <u>20</u> ft. Dia _____ in. to _____ ft. Dia _____ in. to _____ ft. Casing height above land surface <u>0</u> in., weight _____ lbs./ft. Wall thickness or gauge No. <u>Schedule 40</u> TYPE OF SCREEN OR PERFORATION MATERIAL: 1 Steel 3 Stainless steel 5 Fiberglass <u>7 PVC</u> 10 Asbestos-cement 2 Brass 4 Galvanized steel 6 Concrete tile 9 ABS 11 Other (specify) _____ 12 None used (open hole) _____ SCREEN OR PERFORATION OPENINGS ARE: 1 Continuous slot <u>3 Mill slot</u> 5 Gauzed wrapped 8 Saw cut 11 None (open hole) 2 Louvered shutter 4 Key punched 6 Wire wrapped 9 Drilled holes 7 Torch cut 10 Other (specify) _____ SCREEN-PERFORATED INTERVALS: From <u>20</u> ft. to <u>35</u> ft. From _____ ft. to _____ ft. From _____ ft. to _____ ft. From _____ ft. to _____ ft. GRAVEL PACK INTERVALS: From <u>17.5</u> ft. to <u>35</u> ft. From _____ ft. to _____ ft. From _____ ft. to _____ ft. From _____ ft. to _____ ft.	
6 GROUT MATERIAL: 1 Neat cement <u>2 Cement grout</u> <u>3 Bentonite</u> 4 Other _____ Grout Intervals: From <u>0</u> ft. to <u>1</u> (cement) From <u>1</u> ft. to <u>17.5</u> (bent) From _____ ft. to _____ ft. What is the nearest source of possible contamination: 1 Septic tank 4 Lateral lines 7 Pit privy <u>11 Fuel storage</u> 14 Abandoned water well 2 Sewer lines 5 Cess pool 8 Sewage lagoon 12 Fertilizer storage 15 Oil well/Gas well 3 Watertight sewer lines 6 Seepage pit 9 Feedyard 13 Insecticide storage 16 Other (specify below) _____ Direction from well? <u>N</u> How many feet? <u>5</u>	
<table border="1" style="width:100%; border-collapse: collapse;"><thead><tr><th>FROM</th><th>TO</th><th>LITHOLOGIC LOG</th><th>FROM</th><th>TO</th><th>PLUGGING INTERVALS</th></tr></thead><tbody><tr><td>0</td><td>6"</td><td>Concrete pad</td><td></td><td></td><td></td></tr><tr><td>6"</td><td>8'</td><td>Clay, black, silty</td><td></td><td></td><td></td></tr><tr><td>8</td><td>12</td><td>Silt, grayish brown, clayey</td><td></td><td></td><td></td></tr><tr><td>12</td><td>25</td><td>Silt, brown, clayey, fine sand</td><td></td><td></td><td></td></tr><tr><td>25</td><td>30</td><td>Sand, grayish brown, silty</td><td></td><td></td><td></td></tr><tr><td>30</td><td>35</td><td>Silt, brown, fine sand</td><td></td><td></td><td></td></tr>
7 CONTRACTOR'S OR LANDOWNER'S CERTIFICATION: This water well was <u>(1) constructed</u> (2) reconstructed, or (3) plugged under my jurisdiction and was completed on (mo/day/year) <u>7-23-91</u> and this record is true to the best of my knowledge and belief. Kansas Water Well Contractor's License No. <u>527</u> This Water Well Record was completed on (mo/day/yr) <u>8-21-91</u> under the business name of <u>GeoCore Services, Inc.</u> by (signature) <u>Dan. Bell</u>	