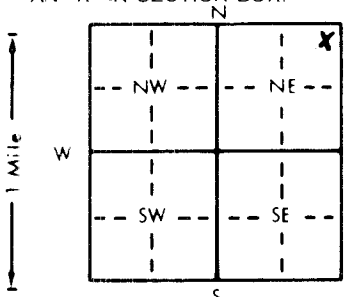


1 LOCATION OF WATER WELL:		Fraction	Section Number		Township Number	Range Number
County: Saline		NE $\frac{1}{4}$ NE $\frac{1}{4}$ NE $\frac{1}{4}$	2		T 14 S	R 3 E (W)
Distance and direction from nearest town or city street address of well if located within city? 1745 N 9th, Salina, Ks MW 8						
2 WATER WELL OWNER: C.L. Clark						
RR#, St Address, Box # : 129 S 8th						
City, State, ZIP Code : Salina, Ks. 67401						
Board of Agriculture, Division of Water Resources Application Number:						
3 LOCATE WELL'S LOCATION WITH AN "X" IN SECTION BOX:		4 DEPTH OF COMPLETED WELL: 35 ft. ELEVATION:				
		Depth(s) Groundwater Encountered 1. ft. 2. ft. 3. ft. WELL'S STATIC WATER LEVEL 30.68 ft. below land surface measured on mo/day/yr 8-21-91 Pump test data: Well water was ft. after hours pumping gpm Est. Yield gpm Well water was ft. after hours pumping gpm Bore Hole Diameter: 7 5/8 in. to 35 ft. and in. to ft. WELL WATER TO BE USED AS: 5 Public water supply 8 Air conditioning 11 Injection well 1 Domestic 3 Feedlot 6 Oil field water supply 9 Dewatering 12 Other (Specify below) 2 Irrigation 4 Industrial 7 Lawn and garden only (10 Monitoring well) Was a chemical/bacteriological sample submitted to Department? Yes No X If yes, mo day yr sample was submitted Water Well Disinfected? Yes No X				
5 TYPE OF BLANK CASING USED:						
1 Steel 3 RMP (SR) 5 Wrought iron 8 Concrete tile CASING JOINTS: Glued Clamped (2 PVC) 4 ABS 6 Asbestos-Cement 9 Other (specify below) Welded 7 Fiberglass Threaded. X						
Blank casing diameter 2 in. to 25 ft. Dia in. to ft. Dia in. to ft. Casing height above land surface 24 in. weight lbs./ft. Wall thickness or gauge No. Sch 40						
TYPE OF SCREEN OR PERFORATION MATERIAL:						
1 Steel 3 Stainless steel 5 Fiberglass (7 PVC) 10 Asbestos-cement 2 Brass 4 Galvanized steel 6 Concrete tile 8 RMP (SR) 11 Other (specify) 12 None used (open hole)						
SCREEN OR PERFORATION OPENINGS ARE:						
1 Continuous slot (3 Mill slot) 5 Gauzed wrapped 8 Saw cut 11 None (open hole) 2 Louvered shutter 4 Key punched 6 Wire wrapped 9 Drilled holes 7 Torch cut 10 Other (specify)						
SCREEN-PERFORATED INTERVALS: From 25 ft. to 35 ft. From ft. to ft. From ft. to ft. From ft. to ft.						
GRAVEL PACK INTERVALS: From 23 ft. to 35 ft. From ft. to ft. From ft. to ft. From ft. to ft.						
6 GROUT MATERIAL: 1 Neat cement (2 Cement grout) (3 Bentonite) 4 Other						
Grout intervals: From 0 ft. to 19 (cement) From 19 ft. to 23 ft. From ft. to ft.						
What is the nearest source of possible contamination:						
1 Septic tank 4 Lateral lines 7 Pit privy (11 Fuel storage) 14 Abandoned water well 2 Sewer lines 5 Cess pool 8 Sewage lagoon 12 Fertilizer storage 15 Oil well/Gas well 3 Watertight sewer lines 6 Seepage pit 9 Feedyard 13 Insecticide storage 16 Other (specify below)						
Direction from well? SE How many feet? 20						
FROM	TO	LITHOLOGIC LOG		FROM	TO	PLUGGING INTERVALS
0	6	Clay, lt. brown, silty				
6	9	Clay, black, silty				
9	17	Clay, brown, sandy, silty				
17	25	Sand, brown, fine				
25	26	Silt, brown, sandy				
26	29	Sand, yellow, fine				
29	35	Clay, grey, silty				
7 CONTRACTOR'S OR LANDOWNER'S CERTIFICATION: This water well was (1) constructed (2) reconstructed, or (3) plugged under my jurisdiction and was completed on (mo/day/year) 7-23-91 and this record is true to the best of my knowledge and belief. Kansas Water Well Contractor's License No. 527 This Water Well Record was completed on (mo/day/yr) 8-21-91 under the business name of GeoCore Services, Inc. by (signature) Dai Bell						