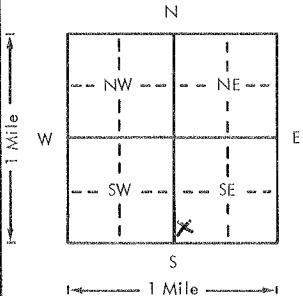


USE TYPEWRITER OR BALL
POINT PEN-PRESS FIRMLY,
PRINT CLEARLY.

WATER WELL RECORD
KSA 82a-1201-1215

Kansas Department of Health and
Environment-Division of Environment
(Water well Contractors)
Topeka, Kansas 66620

1. Location of well:		County Saline	Fraction SW 1/4 SW 1/4 SE 1/4	Section number 10	Township number T 14 S	Range number R 3 W E/W
2. Distance and direction from nearest town or city: Street address of well location if in city: 1 Mi W Salina			3. Owner of well: Red Construction Co R.R. or street: 1524 E Iron City, state, zip code: Salina Kans			
4. Locate with "X" in section below: 			Sketch map:			6. Bore hole dia. 8 in. Completion date 10/4/79 Well depth 63 ft.
5. Type and color of material <i>In feet below LS</i>			From	To	7. ☒ Cable tool ☒ Rotary ☐ Driven ☐ Dug ☐ Hollow rod ☐ Jetted ☐ Bored ☐ Reverse rotary	
					8. Use: ☐ Domestic ☐ Public supply ☒ Industry ☐ Irrigation ☐ Air conditioning ☐ Stock ☐ Lawn ☐ Oil field water ☐ Other	
					9. Casing: Material ☐ Height ☒ Above or below Threaded ☐ Welded ☐ Surface 12 in. RMP ☒ PVC ☐ Weight ☐ lbs./ft. Dia. 6 in. to 63 ft. depth Wall Thickness: inches or Dia. ☐ in. to ☐ ft. depth gauge No. 200	
					10. Screen: Manufacturer's name shop Type slots Dia. 6" Slot/gauze 1/16" Length 3' Set between 60 ft. and 63 ft. ft. and ft. Gravel pack? ☒ Size range of material 1/10"	
					11. Static water level: 13 ft. below land surface Date 10/4/79 mo./day/yr.	
			12. Pumping level below land surfaces: 10 ft. after 1 hrs. pumping 20 g.p.m. ☐ ft. after ☐ hrs. pumping ☐ g.p.m. Estimated maximum yield 40 g.p.m.			
			13. Water sample submitted: mo./day/yr. Yes ☒ No ☐ Date			
			14. Well head completion: ☐ Pitless adapter 12 inches above grade			
			15. Well grouted? ☒ With: ☒ Neat cement ☐ Bentonite ☐ Concrete Depth: From 3 ft. to 13 ft.			
			16. Nearest source of possible contamination: ft. 300' Direction SW Type land fill Well disinfected upon completion? ☒ Yes ☐ No			
			17. Pump: ☒ Not installed Manufacturer's name Model number HP Volts Length of drop pipe ft. capacity g.p.m. Type: ☐ Submersible ☐ Turbine ☐ Jet ☐ Reciprocating ☐ Centrifugal ☐ Other			
18. Elevation:			19. Remarks:			
Topography: ☐ Hill ☐ Slope ☐ Upland ☒ Valley			20. Water well contractor's certification: This well was drilled under my jurisdiction and this report is true to the best of my knowledge and belief. Hydraulic Drilling 126 Business name License No. Address Salina Kans Signed Def Lent Date 10/9/79 Authorized representative			

Forward the white, blue and pink copies to the Department of Health and Environment

Form WWC-5