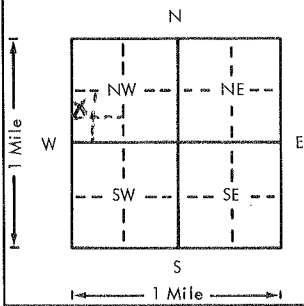
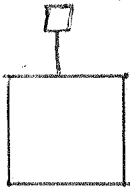


USE TYPEWRITER OR BALL
POINT PEN-PRESS FIRMLY,
PRINT CLEARLY.

WATER WELL RECORD
KSA 82a-1201-1215

Kansas Department of Health and
Environment-Division of Environment
(Water well Contractors)
Topeka, Kansas 66620

1. Location of well:	County Saline	Fraction NW 1/4 SW 1/4 NW 1/4	Section number 10	Township number T 14 S	Range number R 3 E
2. Distance and direction from nearest town or city: 1 mile west of Salina		3. Owner of well: Joe Wesley R.R. or street: Tea Table Investments City, state, zip code: Box 91 Salina, Ks. 67401			
4. Locate with "X" in section below:		Sketch map:		6. Bore hole dia. 8 in. Completion date 2/11/77 Well depth 73 ft.	
				7. <input checked="" type="checkbox"/> Cable tool <input checked="" type="checkbox"/> Rotary <input type="checkbox"/> Driven <input type="checkbox"/> Dug <input type="checkbox"/> Hollow rod <input type="checkbox"/> Jetted <input type="checkbox"/> Bored <input type="checkbox"/> Reverse rotary	
5. Type and color of material		From	To	8. Use: <input checked="" type="checkbox"/> Domestic <input type="checkbox"/> Public supply <input type="checkbox"/> Industry <input type="checkbox"/> Irrigation <input type="checkbox"/> Air conditioning <input type="checkbox"/> Stock <input type="checkbox"/> Lawn <input type="checkbox"/> Oil field water <input type="checkbox"/> Other	
Top soil		0	5	9. Casing: Material plst Height: Above or below Threaded <input type="checkbox"/> Welded gl Surface 18 in. RMP <input checked="" type="checkbox"/> PVC <input type="checkbox"/> Weight <input type="checkbox"/> lbs./ft. Dia. 5 in. to 73 ft. depth Wall Thickness: inches or Dia. <input type="checkbox"/> in. to <input type="checkbox"/> ft. depth gage No. 0.258	
Black clay		5	30	10. Screen: Manufacturer's name Western Plastics Type RMP Dia. 5" Slot/gauze 3/32 Length 10' Set between 63 ft. and 73 ft. ft. and ft. Gravel pack? Yes Size range of material 1/16 to 3/8	
Sand		30	58	11. Static water level: 25' ft. below land surface Date 2/11/77 mo./day/yr.	
1/8 to 1/4" gravel		58	73	12. Pumping level below land surfaces: ft. after hrs. pumping g.p.m. ft. after hrs. pumping g.p.m. Estimated maximum yield 20 g.p.m.	
				13. Water sample submitted: mo./day/yr. <input type="checkbox"/> Yes <input checked="" type="checkbox"/> No Date	
				14. Well head completion: <input checked="" type="checkbox"/> Pitless adapter <input type="checkbox"/> Inches above grade	
				15. Well grouted? Yes With: <input checked="" type="checkbox"/> Neat cement <input type="checkbox"/> Bentonite <input type="checkbox"/> Concrete Depth: From 0 ft. to 10 ft.	
				16. Nearest source of possible contamination: ft. 100 Direction N.W.E. Type sewer Well disinfected upon completion? <input checked="" type="checkbox"/> Yes <input type="checkbox"/> No	
				17. Pump: Not installed Manufacturer's name Dempster Model number 1/2 HP 220 Volts Length of drop pipe 60 ft. capacity 12 g.p.m. Type: <input checked="" type="checkbox"/> Submersible <input type="checkbox"/> Turbine <input type="checkbox"/> Jet <input type="checkbox"/> Reciprocating <input type="checkbox"/> Centrifugal <input type="checkbox"/> Other	
18. Elevation:		19. Remarks:		20. Water well contractor's certification: This well was drilled under my jurisdiction and this report is true to the best of my knowledge and belief. Rader Drilling Co. 194 Business name Address Carlton, Kansas 67429 License No. Signed Brent E. Rader Date 2-11-77 Authorized representative	

Forward the white, blue and pink copies to the Department of Health and Environment

Form WWC-5