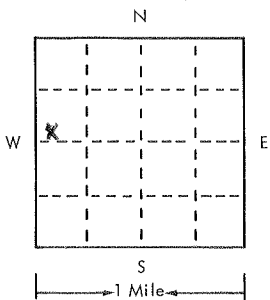


USE TYPEWRITER OR BALL
POINT PEN-PRESS FIRMLY,
PRINT CLEARLY.

WATER WELL RECORD
KSA 82a-1201-1215

T R EW sec 1/4 1/4 1/4 No.

Kansas State Dept. Of Health
(Water Well Contractors)
Forbes-Bldg. 740
Topeka, Kansas 66620

1 Location of well:	County <u>Saline</u>	Township name <u>Sec 5 W NW</u>	Fraction <u>11</u>	Section number <u>145</u>	Town number <u>3 W</u>	Range number
Distance and direction from nearest town or city:			3 Owner of well: <u>Metcon Corp.</u>			
Street address of well location if in city:			Address: <u>Rt. 2 Saline</u>			
Locate with "X" in section below: 			Sketch map:			4 Well depth: <u>75.5</u> ft. Date of completion <u>6-30-75</u> Well diameter <u>4</u> in.
2 Type and color of material			From		To	5 ☐ Cable tool ☒ Rotary ☐ Driven ☐ Dug ☐ Hollow rod ☐ Jetted ☐ Bored ☐ Reverse rotary
						6 Use: ☐ Domestic ☐ Public supply ☒ Industry ☐ Irrigation ☐ Air conditioning ☐ Commercial ☐ Test well ☐
40 p 48 Alluvium: Clay, silty, gray-brown Sand, fine to medium, little gravel Gravel, fine to medium & sand Clay, buff Gravel, fine to coarse & sand, part cement Wellington fm: Shale, blue-gray			7 Casing: Material <u>RMP</u> Height: <u>above</u> /below Threaded ☐ Welded ☐ Surface <u>12</u> in. Diam. <u>4</u> in. to <u>75.5</u> ft. depth Drive shoe? ☐ Yes ☐ No <u>4</u> in. to <u>75.5</u> ft. depth			8 Screen: Manufacturer <u>Slope</u> Type <u>RMP</u> Dia. <u>4</u> Slot/gauze <u>1/16</u> Length <u>3</u> Set between <u>73</u> ft. and <u>75</u> ft. Fittings: Gravel pack ☒ Yes ☐ No Size range of material <u>2 mm</u>
			9 Static water level: <u>15</u> ft. below land surface Date <u>6-30-75</u>			10 Pumping level below land surfaces: ____ ft. after <u>1/2</u> hrs. pumping <u>40</u> g.p.m. ____ ft. after ____ hrs. pumping ____ g.p.m. Estimated maximum yield <u>60</u> g.p.m.
(use a second sheet if needed)			11 Water sample submitted: ☐ Yes ☒ No Date ____			12 Well head completion: ☐ Pitless adapter ☒ Inches above grade
			13 Well grouted? ☒ Yes ☐ No ☒ Neat cement ☐ Bentonite ☐ Depth: From <u>3</u> ft. to <u>13</u> ft.			14 Nearest source of possible contamination: ft. ____ Direction ____ Type ____ Well disinfected upon completion? ☒ Yes ☐ No
16 Remarks: elevation Topography: ☐ Hill ☐ Slope ☐ Upland ☐ Valley			15 Pump: ☒ Not installed Manufacturer's name ____ Model number ____ HP ____ Volts ____ Length of drop pipe ____ ft. capacity ____ g.m.p. Type: ☐ Submersible ☐ Turbine ☐ Jet ☐ Reciprocating ☐ Centrifugal ☐ Other			17 Water well contractor's certification: This well was drilled under my jurisdiction and this report is true to the best of my knowledge and belief. <u>Hydraulic Drilling</u> <u>126</u> Business name License No. Address <u>Saline, KS</u> Signed <u>[Signature]</u> Date <u>7-25-75</u> Authorized Representative