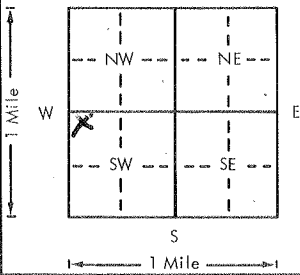


USE TYPEWRITER OR BALL POINT PEN-PRESS FIRMLY, PRINT CLEARLY.

WATER WELL RECORD
KSA 82a-1201-1215

Kansas Department of Health and Environment-Division of Environment
(Water well Contractors)
Topeka, Kansas 66620

1. Location of well:		County Saline	Fraction NW 1/4 NW 1/4 SW 1/4	Section number 11	Township number T 14 S R 3W	Range number E/W
2. Distance and direction from nearest town or city: Street address of well location if in city: 1/4 Mi. W. Saline			3. Owner of well: Abbott Construction Co R.R. or street: Rt 2 City, state, zip code: Saline Kans 67401			
4. Locate with "X" in section below: N W E S 1 Mile		Sketch map: 		6. Bore hole dia: 6 in. Completion date: 10/16/78 Well depth: 74 ft.		
5. Type and color of material		From	To	7. <input type="checkbox"/> Cable tool <input checked="" type="checkbox"/> Rotary <input type="checkbox"/> Driven <input type="checkbox"/> Dug <input type="checkbox"/> Hollow rod <input type="checkbox"/> Jetted <input type="checkbox"/> Bored <input type="checkbox"/> Reverse rotary		
Clay & silt, gray & light brown		0	21	8. Use: <input type="checkbox"/> Domestic <input type="checkbox"/> Public supply <input checked="" type="checkbox"/> Industry <input type="checkbox"/> Irrigation <input type="checkbox"/> Air conditioning <input type="checkbox"/> Stock <input type="checkbox"/> Lawn <input type="checkbox"/> Oil field water <input type="checkbox"/> Other		
Sand, fine to medium & gravel, fine		21	48	9. Casing: Material <input type="checkbox"/> Height: Above of below Threaded <input type="checkbox"/> Welded <input type="checkbox"/> Surface 12 in. RMP <input checked="" type="checkbox"/> PVC <input type="checkbox"/> Weight <input type="checkbox"/> lbs./ft. Dia. 4 in. to 74 ft. depth Wall Thickness: inches or Dia. <input type="checkbox"/> in. to <input type="checkbox"/> ft. depth gage No. 200		
Sand, fine to coarse, partly cemented		48	51	10. Screen: Manufacturer's name Shop Type slots Dia. 4" Slot/gauze 1/16" Length 3' Set between 71 ft. and 74 ft. <input type="checkbox"/> ft. and <input type="checkbox"/> ft. Gravel pack? <input checked="" type="checkbox"/> Size range of material 4/10"		
Gravel, fine to coarse & sand		51	62	11. Static water level: <input type="checkbox"/> mo./day/yr. 19 ft. below land surface Date 10/16/78		
Sand, fine to medium		62	71	12. Pumping level below land surfaces: ND ft. after 1 hrs. pumping 25 g.p.m. <input type="checkbox"/> ft. after <input type="checkbox"/> hrs. pumping <input type="checkbox"/> g.p.m. Estimated maximum yield 40 g.p.m.		
Gravel, fine to coarse & sand		71	74	13. Water sample submitted: <input type="checkbox"/> mo./day/yr. <input type="checkbox"/> Yes <input checked="" type="checkbox"/> No Date <input type="checkbox"/>		
				14. Well head completion: <input type="checkbox"/> Pitless adapter 12 Inches above grade		
				15. Well grouted? <input checked="" type="checkbox"/> With: <input checked="" type="checkbox"/> Neat cement <input type="checkbox"/> Bentonite <input type="checkbox"/> Concrete Depth: From 0 ft. to 10 ft.		
				16. Nearest source of possible contamination: ft. 1/8 Mi Direction S Type Tank Well disinfected upon completion? <input checked="" type="checkbox"/> Yes <input type="checkbox"/> No		
				17. Pump: <input checked="" type="checkbox"/> Not installed Manufacturer's name <input type="checkbox"/> Model number <input type="checkbox"/> HP <input type="checkbox"/> Volts <input type="checkbox"/> Length of drop pipe <input type="checkbox"/> ft. capacity <input type="checkbox"/> g.p.m. Type: <input type="checkbox"/> Submersible <input type="checkbox"/> Turbine <input type="checkbox"/> Jet <input type="checkbox"/> Reciprocating <input type="checkbox"/> Centrifugal <input type="checkbox"/> Other		
				(Use a second sheet if needed)		
18. Elevation: Topography: <input type="checkbox"/> Hill <input type="checkbox"/> Slope <input type="checkbox"/> Upland <input checked="" type="checkbox"/> Valley		19. Remarks: Water quality reported increasingly poorer in this area in last 3 years. Reported increased Fe & H2S		20. Water well contractor's certification: This well was drilled under my jurisdiction and this report is true to the best of my knowledge and belief. Hydraulic Drilling Co - 126 Business name License No. Address Saline Kansas Signed [Signature] Date 11/7/78 Authorized representative		

T 14 S R 3W E 11 NW 1/4 SW 1/4

4225