


| | | | | |
|---------------------------|----------------------|----------------|-----------------|--------------|
| 1 LOCATION OF WATER WELL: | Fraction | Section Number | Township Number | Range Number |
| County: SALINE | NW 1/4 SE 1/4 SE 1/4 | 11 | T 14 S | R 3 E/W |

| | | | | |
|---------------------------|----------------------|----------------|-----------------|--------------|
| 1 LOCATION OF WATER WELL: | Fraction | Section Number | Township Number | Range Number |
| County: SALINE | NW 1/4 SE 1/4 SE 1/4 | 11 | T 14 S | R 3 E/W |

Distance and direction from nearest town or city street address of well if located within city?
917 N. 13th

| | | |
|----------------------------------|-------------------|---|
| 2] WATER WELL OWNER: BILL NELSON | | |
| RR#, St. Address, Box # : | 917 N. 13th #22 | Board of Agriculture, Division of Water Resources |
| City, State, ZIP Code : | SALINA, KS. 67401 | Application Number: |

LOCATE WELL'S LOCATION WITH AN "X" IN SECTION BOX: 4 DEPTH OF COMPLETED WELL: 58 ft. ELEVATION: 1217

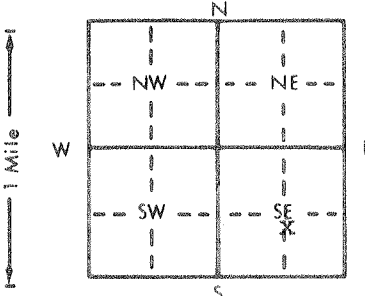

Depth(s) Groundwater Encountered 1. ft. 2. ft. 3. ft.

WELL'S STATIC WATER LEVEL . . . 27 ft. below land surface measured on mo/day/yr . . . 6-11-90

Pump test data: Well water was . . . 30 ft. after . . . 2 hours pumping . . . 10 gpm

Est. Yield . . . 50+ . . . gpm: Well water was ft. after hours pumping gpm

Bore Hole Diameter . . . 9 in. to . . . 58 ft., and in. to ft.

WELL WATER TO BE USED AS:

| | | | | |
|-----------------------|--------------------|--------------------------|--------------------|--------------------------|
| 5 Public water supply | 8 Air conditioning | 11 Injection well | | |
| 1 Domestic | 3 Feedlot | 6 Oil field water supply | 9 Dewatering | 12 Other (Specify below) |
| 2 Irrigation | 4 Industrial | 7 Lawn and garden only | 10 Monitoring well | |

Was a chemical/bacteriological sample submitted to Department? Yes. No. X; If yes, mo/day/yr sample was submitted

Water Well Disinfected? Yes X No

| | | | | |
|---|------------|-------------------|-------------------------|--|
| 5 TYPE OF BLANK CASING USED: | | 5 Wrought iron | 8 Concrete tile | CASING JOINTS: Glued X Clamped |
| 1 Steel | 3 RMP (SR) | 6 Asbestos-Cement | 9 Other (specify below) | Welded |
| 2 PVC | 4 ABS | 7 Fiberglass | | Threaded |
| Blank casing diameter 5 in. to 48 ft., Dia in. to ft., Dia in. to ft. | | | | |
| Casing height above land surface 24 in., weight 160 lbs./ft. Wall thickness or gauge No. SDR 26 | | | | |

| | | | | |
|---|--------------------|-----------------|--------------|------------------------------|
| TYPE OF SCREEN OR PERFORATION MATERIAL: | | | <u>7 PVC</u> | 10 Asbestos-cement |
| 1 Steel | 3 Stainless steel | 5 Fiberglass | 8 RMP (SR) | 11 Other (specify) |
| 2 Brass | 4 Galvanized steel | 6 Concrete tile | 9 ABS | 12 None used (open hole) |

SCREEN OR PERFORATION OPENINGS ARE:

| | | | | |
|--------------------|------------------|------------------|--------------------------|---------------------|
| 1 Continuous slot | 3 Mill slot .035 | 5 Gauzed wrapped | 8 Saw cut | 11 None (open hole) |
| 2 Louvered shutter | 4 Key punched | 6 Wire wrapped | 9 Drilled holes | |
| | | 7 Torch cut | 10 Other (specify) | |

6 GROUT MATERIAL: 1 Neat cement 2 Cement grout 3 Bentonite 4 Other
Grout Intervals: From 0 ft. to 30 ft. From ft. to ft. From ft. to ft.
What is the nearest source of possible contamination:
1 Septic tank 4 Lateral lines 7 Pit privy 10 Livestock pens 14 Abandoned water well
2 Sewer lines 5 Cess pool 8 Sewage lagoon 11 Fuel storage 15 Oil well/Gas well
3 Watertight sewer lines 6 Seepage pit 9 Feedyard 12 Fertilizer storage 16 Other (specify below)
Direction from well? NORTH How many feet? 26

[illegible]

7 CONTRACTOR'S OR LANDOWNER'S CERTIFICATION: This water well was (1) constructed, (2) reconstructed, or (3) plugged under my jurisdiction and was completed on (mo/day/year) 6-11-90 and this record is true to the best of my knowledge and belief. Kansas Water Well Contractor's License No. 388 This Water Well Record was completed on (mo/day/yr) 6-12-90 under the business name of PESTINGER PUMP SERVICE by (signature) Paul Pestinger