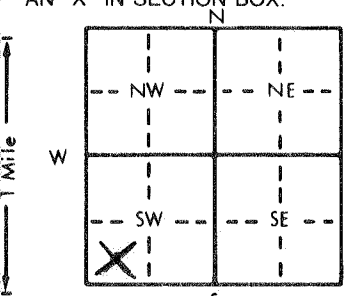


1 LOCATION OF WATER WELL:	Fraction	Section Number	Township Number	Range Number
County: Saline	SW 1/4 SW 1/4 SW 1/4	11	T 14 S	R 3

Distance and direction from nearest town or city street address of well if located within city?

1/4 mile West of Salina, KS

2 WATER WELL OWNER: C.A.V.L.	Board of Agriculture, Division of Water Resources
RR#, St. Address, Box # : P.O. Box 1296	Application Number:
City, State, ZIP Code : Casa Grande, AZ 85222	

3 LOCATE WELL'S LOCATION WITH AN "X" IN SECTION BOX:	4 DEPTH OF COMPLETED WELL: .81 ft. ELEVATION:
	Depth(s) Groundwater Encountered 1. .24 ft. 2. . ft. 3. . ft.
	WELL'S STATIC WATER LEVEL .24 ft. below land surface measured on mo/day/yr 3-5-91
	Pump test data: Well water was . ft. after . hours pumping . gpm
	Est. Yield 20-60 gpm: Well water was . ft. after . hours pumping . gpm
	Bore Hole Diameter .8 in. to .86 ft. and . in. to . ft.
	WELL WATER TO BE USED AS:
	5 Public water supply 8 Air conditioning 11 Injection well
	1 Domestic 3 Feedlot 6 Oil field water supply 9 Dewatering 12 Other (Specify below)
	2 Irrigation 4 Industrial 7 Lawn and garden only 10 Monitoring well
	Was a chemical/bacteriological sample submitted to Department? Yes. . No. <u>X</u> .; If yes, mo/day/yr sample was submitted
	Water Well Disinfected? Yes <u>X</u> No

5 TYPE OF BLANK CASING USED:	5 Wrought iron	8 Concrete tile	CASING JOINTS: Glued <u>X</u> Clamped
1 Steel	3 RMP (SR)	6 Asbestos-Cement	9 Other (specify below)
2 PVC	4 ABS	7 Fiberglass	Threaded
Blank casing diameter 5 in. to 61 ft., Dia in. to ft., Dia in. to ft.			
Casing height above land surface 12 in., weight 2.37 lbs./ft. Wall thickness or gauge No. .214			
TYPE OF SCREEN OR PERFORATION MATERIAL:	7 PVC	10 Asbestos-cement	
1 Steel	3 Stainless steel	5 Fiberglass	8 RMP (SR)
2 Brass	4 Galvanized steel	6 Concrete tile	9 ABS
11 Other (specify)			
12 None used (open hole)			
SCREEN OR PERFORATION OPENINGS ARE:	5 Gauzed wrapped	8 Saw cut	11 None (open hole)
1 Continuous slot	3 Mill slot	6 Wire wrapped	9 Drilled holes
2 Louvered shutter	4 Key punched	7 Torch cut	10 Other (specify)
SCREEN-PERFORATED INTERVALS:	From 61 ft. to 81 ft., From ft. to ft.		
	From ft. to ft., From ft. to ft.		
GRAVEL PACK INTERVALS:	From 25 ft. to 81 ft., From ft. to ft.		
	From ft. to ft., From ft. to ft.		

6 GROUT MATERIAL:	1 Neat cement	2 Cement grout	3 Bentonite	4 Other
Grout Intervals: From 5 ft. to 25 ft., From ft. to ft., From ft. to ft.				
What is the nearest source of possible contamination:	10 Livestock pens	14 Abandoned water well		
1 Septic tank	4 Lateral lines	7 Pit privy	11 Fuel storage	15 Oil well/Gas well
2 Sewer lines	5 Cess pool	8 Sewage lagoon	12 Fertilizer storage	16 Other (specify below)
3 Watertight sewer lines	6 Seepage pit	9 Feedyard	13 Insecticide storage	

Direction from well? East	How many feet? 150 ft.				
FROM	TO	LITHOLOGIC LOG	FROM	TO	PLUGGING INTERVALS
0	4	Top Soil			
4	9	Gray Clay			
9	27	Tan Clay			
27	56	Silty Brown Clays			
56	63	Fine Sand & Creek Gravel			
63	65	Gray Clay			
65	85	Fine sand & creek gravel with small clay layers			
85	86	Shale			

7 CONTRACTOR'S OR LANDOWNER'S CERTIFICATION: This water well was (1) constructed, (2) reconstructed, or (3) plugged under my jurisdiction and was completed on (mo/day/year) 3-5-91 and this record is true to the best of my knowledge and belief. Kansas Water Well Contractor's License No. 138 This Water Well Record was completed on (mo/day/yr) 3-8-91 under the business name of Peterson Irrigation, Inc. by (signature) <u>Meko Peterson</u>
--

INSTRUCTIONS: Use typewriter or ball point pen. PLEASE PRESS FIRMLY and PRINT clearly. Please fill in blanks, underline or circle the correct answers. Send top three copies to Kansas Department of Health and Environment, Bureau of Water, Topeka, Kansas 66620-7320. Telephone: 913-296-5545. Send one to WATER WELL OWNER and retain one for your records.