


LOCATION OF WATER WELL:		Fraction	Section Number	Township Number	Range Number
County: Saline	Near $\frac{1}{2}$ Center $\frac{1}{4}$ NE $\frac{1}{4}$	12	T 14 S	R 3	W

Distance and direction from nearest town or city street address of well if located within city?

In city limits Salina, KS

WATER WELL OWNER:	Duane W. Crooks	
RR#, St. Address, Box # :	716 Smoky Hill Dr.	Board of Agriculture, Division of Water Resources
City, State, ZIP Code :	Salina, KS 67401	Application Number:

LOCATE WELL'S LOCATION WITH AN "X" IN SECTION BOX: 4 DEPTH OF COMPLETED WELL: 69 ft. ELEVATION: 41 ft 3 ft

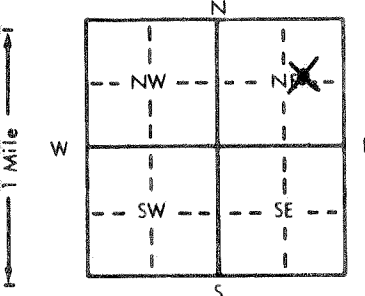

4 DEPTH OF COMPLETED WELL . . . 69 ft. ELEVATION:

Depth(s) Groundwater Encountered 1 41 ft. 2 ft. 3 ft.

WELL'S STATIC WATER LEVEL . . . 41 ft. below land surface measured on mo/day/yr . . . 4-30-92

Pump test data: Well water was ft. after hours pumping gpm

Est. Yield . . . 12 . . . gpm: Well water was . . . 47 ft. after . . . 3/4 . . . hours pumping . . . 12 gpm

Bore Hole Diameter . . . 8 in. to . . . 7.2 ft., and in. to ft.

WELL WATER TO BE USED AS:

5 Public water supply	8 Air conditioning	11 Injection well		
1 Domestic	3 Feedlot	6 Oil field water supply	9 Dewatering	12 Other (Specify below)
2 Irrigation	4 Industrial	7 Lawn and garden only	10 Monitoring well	

Was a chemical/bacteriological sample submitted to Department? Yes No . . . X; If yes, mo/day/yr sample was sub-

mitted Water Well Disinfected? Yes X No

5	TYPE OF BLANK CASING USED:		5 Wrought iron	8 Concrete tile	CASING JOINTS: Glued . ☒ Clamped Welded Threaded.
	1 Steel	3 RMP (SR)	6 Asbestos-Cement	9 Other (specify below)	
	2 PVC	4 ABS	7 Fiberglass		

Blank casing diameter . . . 5 . . . in. to . . . 59 . . . ft., Dia . . . in. to . . . ft., Dia . . . in. to . . . ft.
Casing height above land surface . . . 12 . . . in. weight . . . 2 . 3.7 . . . lbs./ft. Wall thickness or gauge No. . . 2 1 4 . . .

TYPE OF SCREEN OR PERFORATION MATERIAL:			7 PVC	10 Asbestos-cement
1 Steel	3 Stainless steel	5 Fiberglass	8 RMP (SR)	11 Other (specify)
2 Brass	4 Galvanized steel	6 Concrete tile	9 ABS	12 None used (open hole)

SCREEN OR PERFORATION OPENINGS ARE:

1 Continuous slot	3 Mill slot	5 Gauzed wrapped	8 Saw cut	11 None (open hole)
2 Louvered shutter	4 Kev punched	6 Wire wrapped	9 Drilled holes	
		7 Torch cut	10 Other (specify)	

SCREEN-PERFORATED INTERVALS:	From 59	ft. to 69	ft., From	ft. to	ft.
	From	ft. to	ft., From	ft. to	ft.
GRAVEL PACK INTERVALS:	From 25	ft. to 69	ft., From	ft. to	ft.
	From	ft. to	ft., From	ft. to	ft.

6 GROUT MATERIAL: 1 Neat cement 2 Cement grout 3 Bentonite 4 Other

Grout Intervals: From 5 ft to 25 ft. From ft. to ft. From ft. to ft.

What is the nearest source of possible contamination:			10 Livestock pens	14 Abandoned water well
1 Septic tank	4 Lateral lines	7 Pit privy	11 Fuel storage	15 Oil well/Gas well
2 Sewer lines	5 Cess pool	8 Sewage lagoon	12 Fertilizer storage	16 Other (specify below)
3 Watertight sewer lines	6 Seepage pit	9 Feedyard	13 Insecticide storage	

Direction from well? North How many feet? 50 ft

[illegible]

7 CONTRACTOR'S OR LANDOWNER'S CERTIFICATION: This water well was (1) constructed, (2) reconstructed, or (3) plugged under my jurisdiction and was completed on (mo/day/year) 4-30-92 and this record is true to the best of my knowledge and belief. Kansas Water Well Contractor's License No. 138 This Water Well Record was completed on (mo/day/yr) 5-7-92 under the business name of Peterson Irrigation, Inc. by (signature) Mike Peterson

INSTRUCTIONS: Use typewriter or ball point pen. PLEASE PRESS FIRMLY and PRINT clearly. Please fill in blanks, underline or circle the correct answers. Send top three copies to Kansas Department of Health and Environment, Bureau of Water, Topeka, Kansas 66620-0001. Telephone: 913-296-5545. Send one to WATER WELL OWNER and retain one for your records.