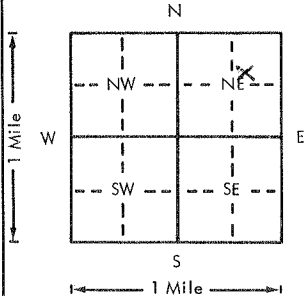


USE TYPEWRITER OR BALL  
POINT PEN-PRESS FIRMLY,  
PRINT CLEARLY.

WATER WELL RECORD  
KSA 82a-1201-1215

Kansas Department of Health and  
Environment-Division of Environment  
(Water well Contractors)  
Topeka, Kansas 66620

1. Location of well:	County <u>Saline</u>	Fraction <u>SW 1/4 NE 1/4 NE 1/4</u>	Section number <u>13</u>	Township number <u>T 14</u>	Range number <u>S R 3 W</u>	E/W
2. Distance and direction from nearest town or city: Street address of well location if in city: <u>1035 Gypsum Saline</u>			3. Owner of well: <u>Richard Tucker</u> R.R. or street: <u>1035 Gypsum</u> City, state, zip code: <u>Saline Kans 67401</u>			
4. Locate with "X" in section below: 			Sketch map: <u>In feet</u>			
5. Type and color of material			From	To	6. Bore hole dia. <u>6</u> in. Completion date <u>4-12-77</u> Well depth <u>55</u> ft.	
<u>Alluvium:</u>					7. <input checked="" type="checkbox"/> Cable tool <input checked="" type="checkbox"/> Rotary <input type="checkbox"/> Driven <input type="checkbox"/> Dug <input type="checkbox"/> Hollow rod <input type="checkbox"/> Jetted <input type="checkbox"/> Bored <input type="checkbox"/> Reverse rotary	
<u>Clay, silty, buff</u>			<u>0</u>	<u>21</u>	8. Use: <input type="checkbox"/> Domestic <input type="checkbox"/> Public supply <input type="checkbox"/> Industry <input type="checkbox"/> Irrigation <input type="checkbox"/> Air conditioning <input type="checkbox"/> Stock <input checked="" type="checkbox"/> Lawn <input type="checkbox"/> Oil field water <input type="checkbox"/> Other	
<u>Gravel, fine to coarse, sand &amp; clay</u>			<u>21</u>	<u>35</u>	9. Casing: Material <u>Plastic</u> Height: <u>Above</u> or below Threaded <input type="checkbox"/> Welded <input type="checkbox"/> Surface <u>12</u> in. RMP <input type="checkbox"/> PVC <input checked="" type="checkbox"/> Weight <u>      </u> lbs./ft. Dia. <u>4</u> in. to <u>55</u> ft. depth Wall Thickness: inches or Dia. <u>      </u> in. to <u>      </u> ft. depth gage No. <u>See 40</u>	
<u>Gravel, fine to coarse, sand &amp; silt</u>			<u>35</u>	<u>40</u>	10. Screen: Manufacturer's name <u>Shop</u> Type <u>slots</u> Dia. <u>4"</u> Slot/gauze <u>3/32</u> Length <u>3'</u> Set between <u>52</u> ft. and <u>55</u> ft. Gravel pack? <input checked="" type="checkbox"/> Size range of material <u>3/8</u>	
<u>Gravel, fine to coarse &amp; sand</u>			<u>40</u>	<u>55</u>	11. Static water level: <u>29</u> ft. below land surface Date <u>4-12-77</u> mo./day/yr.	
					12. Pumping level below land surfaces: <u>41</u> ft. after <u>42</u> hrs. pumping <u>30</u> g.p.m. <u>      </u> ft. after <u>      </u> hrs. pumping <u>      </u> g.p.m. Estimated maximum yield <u>40</u> g.p.m.	
					13. Water sample submitted: <u>      </u> mo./day/yr. <input type="checkbox"/> Yes <input checked="" type="checkbox"/> No Date <u>      </u>	
					14. Well head completion: <u>12</u> inches above grade <input type="checkbox"/> Pitless adapter	
					15. Well grouted? <input checked="" type="checkbox"/> With: <input checked="" type="checkbox"/> Neat cement <input type="checkbox"/> Bentonite <input type="checkbox"/> Concrete Depth: From <u>0</u> ft. to <u>10</u> ft.	
					16. Nearest source of possible contamination: ft. <u>60</u> Direction <u>N</u> Type <u>Garden</u> Well disinfected upon completion? <input checked="" type="checkbox"/> Yes <input type="checkbox"/> No	
					17. Pump: <input checked="" type="checkbox"/> Not installed Manufacturer's name <u>      </u> Model number <u>      </u> HP <u>      </u> Volts <u>      </u> Length of drop pipe <u>      </u> ft. capacity <u>      </u> g.p.m. Type: <input type="checkbox"/> Submersible <input type="checkbox"/> Turbine <input type="checkbox"/> Jet <input type="checkbox"/> Reciprocating <input type="checkbox"/> Centrifugal <input type="checkbox"/> Other	
(Use a second sheet if needed)						
18. Elevation:  Topography: <input type="checkbox"/> Hill <input type="checkbox"/> Slope <input type="checkbox"/> Upland <input checked="" type="checkbox"/> Valley	19. Remarks:		20. Water well contractor's certification: This well was drilled under my jurisdiction and this report is true to the best of my knowledge and belief. <u>Hydraulic Drilling Co-126</u> Business name <u>Saline, Mo</u> License No. <u>      </u> Address <u>      </u> Date <u>5-27-77</u> Signed <u>Art Fennell</u> Authorized representative			

Forward the white, blue and pink copies to the Department of Health and Environment

Form WWC-5