


LOCATION OF WATER WELL:		Fraction		Section Number		Township Number		Range Number	
County:	Saline	SW 1/4	NE 1/4	NE 1/4	13	T 14 S	R 3	XE/W	

Distance and direction from nearest town or city street address of well if located within city?
Within the city limits of Salina, KS.

WATER WELL OWNER:	M. B. Wilcox	
R#, St. Address, Box # :	831 E. Claflin St.	Board of Agriculture, Division of Water Resources
City, State, ZIP Code :	Salina, KS.	Application Number:

LOCATE WELL'S LOCATION WITH AN "X" IN SECTION BOX: 4 DEPTH OF COMPLETED WELL: 52 ft. ELEVATION:
 Depth(s) Groundwater Encountered 1. 25 ft 2. ft 3. ft

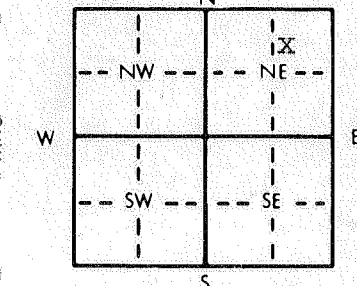

4 DEPTH OF COMPLETED WELL..... 52 ft. ELEVATION:
 Depth(s) Groundwater Encountered 1..... 25 ft. 2..... ft. 3..... ft.
 WELL'S STATIC WATER LEVEL..... 24 ft. below land surface measured on mo/day/yr 10-21--82.....
 Pump test data: Well water was ft. after hours pumping gpm
 Est. Yield 20-50 gpm: Well water was ft. after hours pumping gpm
 Bore Hole Diameter..... 8 in. to 52 ft., and in. to ft.
 WELL WATER TO BE USED AS:
 XX Domestic 3 Feedlot 6 Oil field water supply 9 Dewatering 11 Injection well
 2 Irrigation 4 Industrial 7 Lawn and garden only 10 Observation well
 Was a chemical/bacteriological sample submitted to Department? Yes..... No XX; If yes, mo/day/yr sample was sub-
 mitted Water Well Disinfected? Yes XX No

TYPE OF BLANK CASING USED:		5 Wrought iron	8 Concrete tile	CASING JOINTS: Glued <input checked="" type="checkbox"/>	Clamped
1 Steel	3 RMP (SR)	6 Asbestos-Cement	9 Other (specify below)	Welded	
<input checked="" type="checkbox"/> 2 PVC	4 ABS	7 Fiberglass		Threaded	

Tank casing diameter 4 in. to xxx1942 ft. Dia. in. to _____ ft. Dia. in. to _____ ft.
 Casing height above land surface 12 in. weight xxx19 2.16 lbs./ft. Wall thickness or gauge No. .193

TYPE OF SCREEN OR PERFORATION MATERIAL:

1 Steel	3 Stainless steel	5 Fiberglass	7 PVC	10 Asbestos-cement
2 Brass	4 Galvanized steel	6 Concrete tile	8 RMP (SR)	11 Other (specify)
			9 ABS	12 None used (open hole)

SCREEN OR PERFORATION OPENINGS ARE:

1 Continuous slot	3 Mill slot	5 Gauzed wrapped	8 Saw cut	11 None (open hole)
2 Louvered shutter	4 Key punched	6 Wire wrapped	9 Drilled holes	
		7 Torch cut	10 Other (specify)	

GREEN-PERFORATED INTERVALS: From 42 ft. to 52 ft. From ft. to ft.
From ft. to ft. From ft. to ft.

GRAVEL PACK INTERVALS:	From	12	ft. to	52	ft., From		ft. to		ft.
	From		ft. to		ft., From		ft. to		ft.

GROUT MATERIAL: ☒ Neat cement ☐ 2 Cement grout ☐ 3 Bentonite ☐ 4 Other
 Grout Intervals: From 5 ft. to 15 ft., From _____ ft. to _____ ft., From _____ ft. to _____ ft.

What is the nearest source of possible contamination:

1 Septic tank	4 Lateral lines	7 Pit privy	10 Livestock pens	14 Abandoned water well
2 Sewer lines	5 Cess pool	8 Sewage lagoon	11 Fuel storage	15 Oil well/Gas well
X 3 Watertight sewer lines	6 Seepage pit	9 Feedyard	12 Fertilizer storage	16 Other (specify below)

Direction from well? south

How many feet? 150

[illegible]

CONTRACTOR'S OR LANDOWNER'S CERTIFICATION: This water well was (1) constructed, (2) reconstructed, or (3) plugged under my jurisdiction and was completed on (mo/day/year) 10-21-82 and this record is true to the best of my knowledge and belief. Kansas Water Well Contractor's License No. 138 This Water Well Record was completed on (mo/day/yr) 10-21-82 under the business name of Peterson Irrigation, Inc. by (signature) Mike Peterson

INSTRUCTIONS: Use typewriter or ball point pen, PLEASE PRESS FIRMLY and PRINT clearly. Please fill in blanks, underline or circle the correct answers. Send top three copies to Kansas Department of Health and Environment, Division of Environment, Environmental Geology Section, Topeka, KS 66620. Send one to WATER WELL OWNER and retain one for your records.