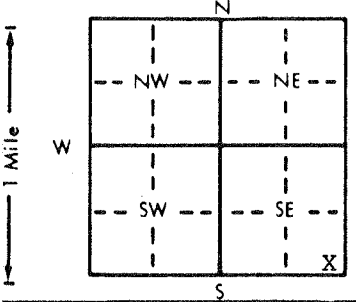


1 LOCATION OF WATER WELL: County: Saline		Fraction SE 1/4 SE 1/4 SE 1/4		Section Number 13		Township Number T 14 S		Range Number R 3 EW	
Distance and direction from nearest town or city street address of well if located within city? 1019 East Crawford, Salina, Kansas									
2 WATER WELL OWNER: Bill Reimold		Board of Agriculture, Division of Water Resources							
RR#, St. Address, Box #: 1012 York Street		Application Number:							
City, State, ZIP Code: Salina, Ks. 67401									
3 LOCATE WELL'S LOCATION WITH AN "X" IN SECTION BOX:		4 DEPTH OF COMPLETED WELL: 42 ft. ELEVATION: 05-20-93							
		Depth(s) Groundwater Encountered 1. ft. 2. ft. 3. ft. WELL'S STATIC WATER LEVEL 30.58 ft. below land surface measured on mo/day/yr Pump test data: Well water was ft. after hours pumping gpm Est. Yield gpm Well water was ft. after hours pumping gpm Bore Hole Diameter: 7 7/8 in. to 45 ft. and in. to ft. WELL WATER TO BE USED AS: 5 Public water supply 8 Air conditioning 11 Injection well 1 Domestic 3 Feedlot 6 Oil field water supply 9 Dewatering 12 Other (Specify below) 2 Irrigation 4 Industrial 7 Lawn and garden only 10 Monitoring well Was a chemical/bacteriological sample submitted to Department? Yes. No. ☒ If yes, mo/day/yr sample was submitted Water Well Disinfected? Yes No ☒							
5 TYPE OF BLANK CASING USED:		CASING JOINTS: Glued Clamped							
1 Steel 3 RMP (SR) 5 Wrought iron 8 Concrete tile		Welded							
2 PVC 4 ABS 6 Asbestos-Cement 9 Other (specify below)		Threaded. ☒							
Blank casing diameter 2 in. to 27 ft. Dia in. to ft. Dia in. to ft.									
Casing height above land surface 3 in., weight lbs./ft. Wall thickness or gauge No.									
TYPE OF SCREEN OR PERFORATION MATERIAL:		7 PVC 10 Asbestos-cement							
1 Steel 3 Stainless steel 5 Fiberglass 8 RMP (SR) 11 Other (specify)									
2 Brass 4 Galvanized steel 6 Concrete tile 9 ABS 12 None used (open hole)									
SCREEN OR PERFORATION OPENINGS ARE:		5 Gauzed wrapped 8 Saw cut 11 None (open hole)							
1 Continuous slot 3 Mill slot 6 Wire wrapped 9 Drilled holes									
2 Louvered shutter 4 Key punched 7 Torch cut 10 Other (specify)									
SCREEN-PERFORATED INTERVALS: From 27 ft. to 42 ft. From ft. to ft.									
GRAVEL PACK INTERVALS: From 25 ft. to 45 ft. From ft. to ft.									
6 GROUT MATERIAL: 1 Neat cement 2 Cement grout 3 Bentonite 4 Other									
Grout Intervals: From 0 ft. to 23 ft. From 23 ft. to 25 ft. From ft. to ft.									
What is the nearest source of possible contamination:		10 Livestock pens 14 Abandoned water well							
1 Septic tank 4 Lateral lines 7 Pit privy 11 Fuel storage 15 Oil well/Gas well									
2 Sewer lines 5 Cess pool 8 Sewage lagoon 12 Fertilizer storage 16 Other (specify below)									
3 Watertight sewer lines 6 Seepage pit 9 Feedyard 13 Insecticide storage									
Direction from well? south southeast		How many feet? 100							
FROM TO LITHOLOGIC LOG FROM TO PLUGGING INTERVALS									
0 6" CONCRETE									
6" 10' GY BRN CLY		Flush mount cover							
10 18 BRN SLTY CLY		MW4							
18 23 SILT		Site Id # 00088222							
23 45 F TO C SND/F TO C GRVL									
7 CONTRACTOR'S OR LANDOWNER'S CERTIFICATION: This water well was 1 constructed, 2 reconstructed, or 3 plugged under my jurisdiction and was completed on (mo/day/year) 05-10-93 and this record is true to the best of my knowledge and belief. Kansas Water Well Contractor's License No. 527 This Water Well Record was completed on (mo/day/yr) 05-21-93 under the business name of GeoCore Services, Inc. by (signature) <i>Doug Ray</i>									
INSTRUCTIONS: Use typewriter or ball point pen. PLEASE PRESS FIRMLY and PRINT clearly. Please fill in blanks, underline or circle the correct answers. Send top three copies to Kansas Department of Health and Environment, Bureau of Water, Topeka, Kansas 66620-0001. Telephone: 913-296-5545. Send one to WATER WELL OWNER and retain one for your records.									