


1 LOCATION OF WATER WELL: Fraction NW 1/4 NE 1/4 NW 1/4 Section Number 10 Township Number T 14 S Range Number R 3 E/W
 County: Salina

Distance and direction from nearest town or city street address of well if located within city?
In Salina. Total Bulk Dist. Station - W. State St. Rd + Hwy 140

2 WATER WELL OWNER: Total Petroleum
 RR#, St. Address, Box #: P.O. Box 500 Board of Agriculture, Division of Water Resources
 City, State, ZIP Code: Denver, Colo. 80201 Application Number:

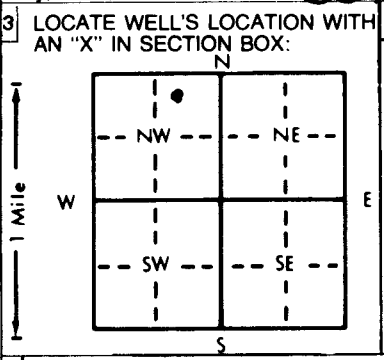

4 DEPTH OF COMPLETED WELL: 18 ft ft. ELEVATION: ft.
 Depth(s) Groundwater Encountered 1 1/2' ft. 2. ft. 3. ft.
 WELL'S STATIC WATER LEVEL 1 1/2' ft. below land surface measured on mo/day/yr 10-13-93
 Pump test data: Well water was ft. after hours pumping gpm
 Est. Yield gpm: Well water was ft. after hours pumping gpm
 Bore Hole Diameter 7 1/2" in. to 18' ft. and in. to ft.
 WELL WATER TO BE USED AS: 5 Public water supply 8 Air conditioning 11 Injection well
 1 Domestic 3 Feedlot 6 Oil field water supply 9 Dewatering 12 Other (Specify below)
 2 Irrigation 4 Industrial 7 Lawn and garden only 10 Monitoring well
 Was a chemical/bacteriological sample submitted to Department? Yes.....No. X.....; If yes, mo/day/yr sample was submitted
 Water Well Disinfected? Yes No

5 TYPE OF BLANK CASING USED: 5 Wrought iron 8 Concrete tile CASING JOINTS: Glued Clamped
 1 Steel 3 RMP (SR) 6 Asbestos-Cement 9 Other (specify below) Welded
2 PVC 4 ABS 7 Fiberglass Threaded. X
 Blank casing diameter 4.42 in. to 1 1/2" ft., Dia in. to ft., Dia in. to ft.
 Casing height above land surface 3' Above Grade in., weight lbs./ft. Wall thickness or gauge No. SDR-13
 TYPE OF SCREEN OR PERFORATION MATERIAL: 7 PVC 10 Asbestos-cement Su40
 1 Steel 3 Stainless steel 5 Fiberglass 8 RMP (SR) 11 Other (specify)
 2 Brass 4 Galvanized steel 6 Concrete tile 9 ABS 12 None used (open hole)
 SCREEN OR PERFORATION OPENINGS ARE: 5 Gauzed wrapped 8 Saw cut 11 None (open hole)
 1 Continuous slot 3 Mill slot .010 6 Wire wrapped 9 Drilled holes
 2 Louvered shutter 4 Key punched 7 Torch cut 10 Other (specify)
 SCREEN-PERFORATED INTERVALS: From 16'6" ft. to 1'6" ft., From ft. to ft.
 From ft. to ft., From ft. to ft.
 GRAVEL PACK INTERVALS: From 18'0" ft. to 1'6" ft., From ft. to ft.
 From ft. to ft., From ft. to ft.

6 GROUT MATERIAL: 1 Neat cement 2 Cement grout 3 Bentonite 4 Other
 Grout intervals: From 1'6" ft. to 1' ft., From 1' ft. to 0' ft., From ft. to ft.
 What is the nearest source of possible contamination:
 1 Septic tank 4 Lateral lines 7 Pit privy 11 Fuel storage 14 Abandoned water well
 2 Sewer lines 5 Cess pool 8 Sewage lagoon 12 Fertilizer storage 15 Oil well/Gas well
 3 Watertight sewer lines 6 Seepage pit 9 Feedyard 13 Insecticide storage 16 Other (specify below)
 Direction from well? South How many feet? 20'

FROM	TO	LITHOLOGIC LOG	FROM	TO	PLUGGING INTERVALS
0	4.0	<u>DK Brown clay</u>			
4.0	15.5	<u>olive green - gray green mottled silty clay w/iron oxide staining</u>			
15.5	18.0	<u>Med. Red Brown - Gray Brown silty clay</u>			

7 CONTRACTOR'S OR LANDOWNER'S CERTIFICATION: This water well was (1 constructed, (2) reconstructed, or (3) plugged under my jurisdiction and was completed on (mo/day/year) 10-13-93 and this record is true to the best of my knowledge and belief. Kansas Water Well Contractor's License No. 539 This Water Well Record was completed on (mo/day/yr) 10-16-93 under the business name of J.B. Environmental Drilling by (signature) James Becker

INSTRUCTIONS: Use typewriter or ball point pen. PLEASE PRESS FIRMLY and PRINT clearly. Please fill in blanks, underline or circle the correct answers. Send top three copies to Kansas Department of Health and Environment, Bureau of Water, Topeka, Kansas 66620-0001. Telephone: 913-296-5545. Send one to WATER WELL OWNER and retain one for your records.