

1	LOCATION OF WATER WELL: County: SALINE	Fraction SW 1/4 SE 1/4 NE 1/4	Section Number 23	Township Number T 14 S	Range Number R 3 EW
---	---	----------------------------------	----------------------	---------------------------	------------------------

Distance and direction from nearest town or city street address of well if located within city?


833 HANSON HOLLOW

2 WATER WELL OWNER: DAN HANSON
RR#, St. Address, Box # : 833 HANSON HOLLOW
City, State, ZIP Code : SALINA, KS. 67401

Board of Agriculture, Division of Water Resources
Application Number:

3 LOCATE WELL'S LOCATION WITH AN "X" IN SECTION BOX:

4 DEPTH OF COMPLETED WELL: 73 ft ELEVATION: 1150

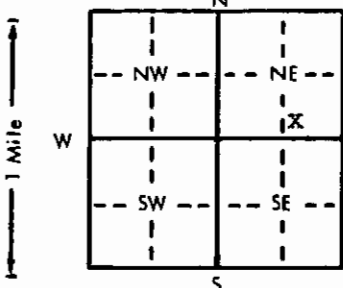

Depth(s) Groundwater Encountered 1. 42 ft. 2. ft. 3. ft.

WELL'S STATIC WATER LEVEL 42 ft. below land surface measured on mo/day/yr 6-29-89

Pump test data: Well water was 55 ft. after 2 hours pumping 25 gpm

Est. Yield 40 gpm: Well water was ft. after hours pumping gpm

Bore Hole Diameter. 9 in. to 73 ft. and in. to ft.

WELL WATER TO BE USED AS:

5 Public water supply	8 Air conditioning	11 Injection well		
1 Domestic	3 Feedlot	6 Oil field water supply	9 Dewatering	12 Other (Specify below)
2 Irrigation	4 Industrial	7 Lawn and garden only	10 Monitoring well	

Was a chemical/bacteriological sample submitted to Department? Yes.....No. X.....; If yes, mo/day/yr sample was submitted

Water Well Disinfected? Yes X No

5 TYPE OF BLANK CASING USED:

- | | |
|---------|------------|
| 1 Steel | 3 RMP (SR) |
| 2 PVC | 4 ABS |

- | | |
|-------------------|-------------------------|
| 5 Wrought iron | 8 Concrete tile |
| 6 Asbestos-Cement | 9 Other (specify below) |
| 7 Fiberglass | |

CASING JOINTS: Glued ☒ Clamped ☐
Welded ☐
Threaded ☐

Blank casing diameter 5 in. to 44 ft. Dia in. to ft. Dia in. to ft.
Casing height above land surface 12 in. weight 160 lbs./ft. Wall thickness or gauge No. SDR 26

TYPE OF SCREEN OR PERFORATION MATERIAL:

- | | |
|---------|--------------------|
| 1 Steel | 3 Stainless steel |
| 2 Brass | 4 Galvanized steel |

- 5 Fiberglass
6 Concrete tile

- | | |
|--------------|------------------------------|
| <u>7 PVC</u> | 10 Asbestos-cement |
| 8 RMP (SR) | 11 Other (specify) |
| 9 ABS | 12 None used (open hole) |

SCREEN OR PERFORATION OPENINGS ARE:

- | | |
|--------------------|----------------------|
| 1 Continuous slot | 3 Mill slot |
| 2 Louvered shutter | <u>4 Key punched</u> |

- 5 Gauzed wrapped
6 Wire wrapped
7 Torch cut

- 8 Saw cut** **11 None (open hole)**

SCREEN-PERFORATED INTERVALS: From 44 ft. to 50 ft. From 63 ft. to 73 ft.

From 73 ft. to 35 ft., From _____ ft. to _____ ft.

GRAVEL PACK INTERVALS: From 73 ft. to 35 ft. From _____ ft. to _____ ft.
From _____ ft. to _____ ft. From _____ ft. to _____ ft.

6 GROUT MATERIAL: 1 Neat cement 2 Cement grout 3 Bentonite 4 Other

Grout Intervals: From 5 ft. to 30 ft. From ft. to ft. From ft. to ft.

What is the nearest source of possible contamination:

- | | |
|--------------------------|-----------------|
| 1 Septic tank | 4 Lateral lines |
| 2 Sewer lines | 5 Cess pool |
| 3 Watertight sewer lines | 6 Seepage pit |


- 7 Pit privy
8 Sewage lagoon
9 Feedyard

- | | |
|------------------------|--------------------------|
| 10 Livestock pens | 14 Abandoned water well |
| 11 Fuel storage | 15 Oil well/Gas well |
| 12 Fertilizer storage | 16 Other (specify below) |
| 13 Insecticide storage | |

Direction from well? NORTH WEST

How many feet? 60

[illegible]

7 CONTRACTOR'S OR LANDOWNER'S CERTIFICATION: This water well was (1) constructed, (2) reconstructed, or (3) plugged under my jurisdiction and was completed on (mo/day/year) 6-29-89 and this record is true to the best of my knowledge and belief. Kansas Water Well Contractor's License No. 388 This Water Well Record was completed on (mo/day/yr) 6-29-89 under the business name of PESTINGER PUMP SERVICE by (signature) 

INSTRUCTIONS: Use typewriter or ball point pen. PLEASE PRESS FIRMLY and PRINT clearly. Please fill in blanks, underline or circle the correct answers. Send top three copies to Kansas Department of Health and Environment, Bureau of Water Protection, Topeka, Kansas 66620-7320. Telephone: 913-296-5514. Send one to WATER WELL OWNER and retain one for your records.