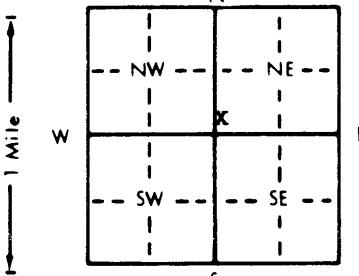


1 LOCATION OF WATER WELL:		Fraction	Section Number		Township Number	Range Number
County: <b>SALINE</b>		<b>SW 1/4 SW 1/4 NE 1/4</b>	<b>24</b>		<b>T 14 S</b>	<b>R 3 EW</b>
Distance and direction from nearest town or city street address of well if located within city? <b>1101 S. OHIO</b>						
2 WATER WELL OWNER: <b>OFFICE CENTER</b>						
RR#, St. Address, Box # : <b>1101 S. OHIO</b>				Board of Agriculture, Division of Water Resources		
City, State, ZIP Code : <b>SALINA, KS. 67401</b>				Application Number:		
3 LOCATE WELL'S LOCATION WITH AN "X" IN SECTION BOX:		4 DEPTH OF COMPLETED WELL: <b>56</b> ft. ELEVATION: <b>1226</b>				
		WELL'S STATIC WATER LEVEL <b>30</b> ft. below land surface measured on mo/day/yr <b>5-2-90</b>				
		Pump test data: Well water was <b>32</b> ft. after <b>1</b> hours pumping <b>30</b> gpm				
		Est. Yield <b>75+</b> gpm: Well water was <b>32</b> ft. after <b>1</b> hours pumping <b>30</b> gpm				
WELL WATER TO BE USED AS:						
5 Public water supply 8 Air conditioning 11 Injection well						
1 Domestic 3 Feedlot 6 Oil field water supply 9 Dewatering 12 Other (Specify below)						
2 Irrigation 4 Industrial 7 Lawn and garden only 10 Monitoring well						
Was a chemical/bacteriological sample submitted to Department? Yes <input checked="" type="checkbox"/> No <input checked="" type="checkbox"/> If yes, mo/day/yr sample was submitted						
Water Well Disinfected? Yes <input checked="" type="checkbox"/> No <input checked="" type="checkbox"/>						
5 TYPE OF BLANK CASING USED:						
1 Steel 3 RMP (SR) 5 Wrought iron 8 Concrete tile CASING JOINTS: Glued <input checked="" type="checkbox"/> Clamped <input checked="" type="checkbox"/>						
2 PVC 4 ABS 6 Asbestos-Cement 9 Other (specify below) Welded <input checked="" type="checkbox"/>						
7 Fiberglass Threaded <input checked="" type="checkbox"/>						
Casing height above land surface <b>12</b> in. weight <b>160</b> lbs./ft. Wall thickness or gauge No. <b>SDR 26</b>						
TYPE OF SCREEN OR PERFORATION MATERIAL:						
1 Steel 3 Stainless steel 5 Fiberglass 8 RMP (SR) 10 Asbestos-cement						
2 Brass 4 Galvanized steel 6 Concrete tile 9 ABS 11 Other (specify)						
12 None used (open hole)						
SCREEN OR PERFORATION OPENINGS ARE:						
1 Continuous slot 3 Mill slot <b>.035</b> 5 Gauzed wrapped 8 Saw cut 11 None (open hole)						
2 Louvered shutter 4 Key punched 6 Wire wrapped 9 Drilled holes						
7 Torch cut 10 Other (specify)						
6 GROUT MATERIAL:						
1 Neat cement 2 Cement grout 3 Bentonite 4 Other						
What is the nearest source of possible contamination:						
1 Septic tank 4 Lateral lines 7 Pit privy 10 Livestock pens 14 Abandoned water well						
2 Sewer lines 5 Cess pool 8 Sewage lagoon 11 Fuel storage 15 Oil well/Gas well						
3 Watertight sewer lines 6 Seepage pit 9 Feedyard 12 Fertilizer storage 16 Other (specify below)						
13 Insecticide storage						
Direction from well? <b>SOUTH</b> How many feet? <b>15</b>						
FROM		TO		LITHOLOGIC LOG		
FROM		TO		PLUGGING INTERVALS		
0		3		TOP SOIL		
3		24		CLAY		
24		37		SAND & GRAVEL		
37		38		CLAY		
38		56		SAND & GRAVEL		
7 CONTRACTOR'S OR LANDOWNER'S CERTIFICATION: This water well was (1) constructed, (2) reconstructed, or (3) plugged under my jurisdiction and was completed on (mo/day/year) <b>5-2-90</b> and this record is true to the best of my knowledge and belief. Kansas Water Well Contractor's License No. <b>388</b> This Water Well Record was completed on (mo/day/yr) <b>5-2-90</b> under the business name of <b>PESTINGER PUMP SERVICE</b> by (signature) <i>Paul Pestinger</i>						
INSTRUCTIONS: Use typewriter or ball point pen. PLEASE PRESS FIRMLY and PRINT clearly. Please fill in blanks, underline or circle the correct answers. Send top three copies to Kansas Department of Health and Environment, Bureau of Water, Topeka, Kansas 66620-7320. Telephone: 913-296-5545. Send one to WATER WELL OWNER and retain one for your records.						