


LOCATION OF WATER WELL:	Fraction	Section Number	Township Number	Range Number
County: <u>Saline</u>	SE ¼ NE ¼ SE ¼	26	T 14 S	R 3 EW

2222 South Ninth, Salina, Kansas

WATER WELL OWNER:	Warta Buick	
RR#, St. Address, Box # :	2222 S. Ninth	Board of Agriculture, Division of Water Resources
City, State, ZIP Code :	Salina, Ks. 67401	Application Number:

LOCATE WELL'S LOCATION WITH AN "X" IN SECTION BOX: 4 DEPTH OF COMPLETED WELL..... 30 ft. ELEVATION: 22.5

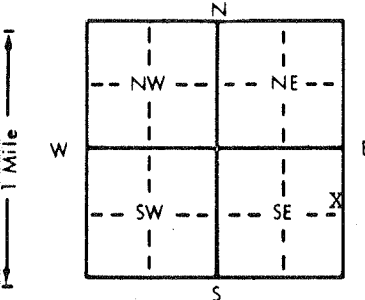

4 DEPTH OF COMPLETED WELL..... 30 ft. ELEVATION:
 Depth(s) Groundwater Encountered 1. 22.5 ft. 2. ft. 3. ft.
 WELL'S STATIC WATER LEVEL 17.5 ft. below land surface measured on mo/day/yr 06-14-93
 Pump test data: Well water was ft. after hours pumping gpm
 Est. Yield gpm: Well water was ft. after hours pumping gpm
 Bore Hole Diameter. 7 5/8 in. to 30 ft., and in. to ft.
 WELL WATER TO BE USED AS: 5 Public water supply 8 Air conditioning 11 Injection well
 1 Domestic 3 Feedlot 6 Oil field water supply 9 Dewatering 12 Other (Specify below)
 2 Irrigation 4 Industrial 7 Lawn and garden only 10 Monitoring well
 Was a chemical/bacteriological sample submitted to Department? Yes.....No.....X.....; If yes, mo/day/yr sample was sub-
 mitted Water Well Disinfected? Yes No X

5	TYPE OF BLANK CASING USED:		5 Wrought iron	8 Concrete tile	CASING JOINTS: Glued Clamped Welded Threaded X
	1 Steel	3 RMP (SR)	6 Asbestos-Cement	9 Other (specify below)	
	② PVC	4 ABS	7 Fiberglass		

Blank casing diameter 2 in. to 15 ft. Dia in. to ft. Dia in. to ft.
Casing height above land surface 0 in. weight lbs./ft. Wall thickness or gauge No. Sch. 40

TYPE OF SCREEN OR PERFORATION MATERIAL:

1 Steel	3 Stainless steel	5 Fiberglass	7 PVC	10 Asbestos-cement
2 Brass	4 Galvanized steel	6 Concrete tile	8 RMP (SR)	11 Other (specify)
			9 ABS	12 None used (open hole)

SCREEN OR PERFORATION OPENINGS ARE:

1 Continuous slot	3 Mill slot	5 Gauzed wrapped	8 Saw cut	11 None (open hole)
2 Louvered shutter	4 Key punched	6 Wire wrapped	9 Drilled holes	
		7 Torch cut	10 Other (specify)	

SCREEN-PERFORATED INTERVALS:	From 15 ft. to 30 ft.,	From ft. to ft.
	From ft. to ft.,	From ft. to ft.
GRAVEL PACK INTERVALS:	From 13 ft. to 30 ft.,	From ft. to ft.
	From ft. to ft.,	From ft. to ft.

8 GROUT MATERIAL: 1 Neat cement 2 Cement grout 3 Bentonite 4 Other
Grout Intervals: From 0 ft. to 11 ft. From 11 ft. to 13 ft. From ft. to ft.

What is the nearest source of possible contamination:

1 Septic tank	4 Lateral lines	7 Pit privy	10 Livestock pens	14 Abandoned water well
2 Sewer lines	5 Cess pool	8 Sewage lagoon	11 Fuel storage	15 Oil well/Gas well
3 Watertight sewer lines	6 Seepage pit	9 Feedyard	12 Fertilizer storage	16 Other (specify below)
			13 Insecticide storage	

Direction from well? southwest How many feet? 80

FROM	TO	LITHOLOGIC LOG	FROM	TO	PLUGGING INTERVALS
0	6"	ASPHALT			
6"	3.5	CLAY, DK GY/ERN, SILTY, SANDY			
3.5	5	CLAY, BLK			
5	8.5	CLAY, GRN/GY, SILTY			
8.5	18	CLAY, GY/BLK			
18	30	CLY, RD/ERN, SILTY			
					KDHE site id 00077963
					MW2
					Flush mount cover

7 CONTRACTOR'S OR LANDOWNER'S CERTIFICATION: This water well was (1) constructed, (2) reconstructed, or (3) plugged under my jurisdiction and was completed on (mo/day/year) 05-20-93 and this record is true to the best of my knowledge and belief. Kansas Water Well Contractor's License No. 527 This Water Well Record was completed on (mo/day/yr) 07-01-93 under the business name of GeoCore Services, Inc. by (signature) [Signature]