

LOCATION OF WATER WELL:	Fraction	Section Number	Township Number	Range Number
County: <u>Saline</u>	<u>NE SE 1/4 NW 1/4 NE 1/4</u>	<u>26</u>	<u>T 14 S</u>	<u>R 3 EW</u>

Distance and direction from nearest town or city street address of well if located within city?

1842 Hageman, Salina, Ks.

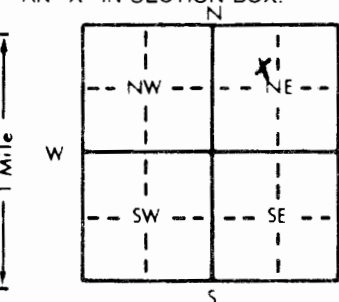
WATER WELL OWNER: C.L. ClarkRR#, St. Address, Box # : 129 S 8th

Board of Agriculture, Division of Water Resources

City, State, ZIP Code : Salina, Ks.

Application Number:

LOCATE WELL'S LOCATION WITH AN "X" IN SECTION BOX:


WELL WATER TO BE USED AS: 5 Public water supply 8 Air conditioning 11 Injection well

1 Domestic 3 Feedlot 6 Oil field water supply 9 Dewatering 12 Other (Specify below)

2 Irrigation 4 Industrial 7 Lawn and garden only 10 Monitoring wellWas a chemical/bacteriological sample submitted to Department? Yes No If yes, mo/day/yr sample was submittedWater Well Disinfected? Yes No

TYPE OF BLANK CASING USED:

1 Steel

3 RMP (SR)

5 Wrought iron

8 Concrete tile

CASING JOINTS: Glued Clamped2 PVC

4 ABS

6 Asbestos-Cement

9 Other (specify below)

Welded

7 Fiberglass


TYPE OF SCREEN OR PERFORATION MATERIAL:

1 Steel

3 Stainless steel

5 Fiberglass

7 PVC

10 Asbestos-cement

2 Brass

4 Galvanized steel

6 Concrete tile

8 RMP (SR)

11 Other (specify)

9 ABS

12 None used (open hole)

SCREEN OR PERFORATION OPENINGS ARE:

1 Continuous slot

3 Mill slot

5 Gauzed wrapped

8 Saw cut

11 None (open hole)

2 Louvered shutter

4 Key punched

6 Wire wrapped

9 Drilled holes

7 Torch cut

10 Other (specify)

SCREEN-PERFORATED INTERVALS:


GROUT MATERIAL:

1 Neat cement

2 Cement grout3 Bentonite

4 Other

Grout Intervals: From 24.5 ft. to 20 (bent) ft. From 20 ft. to 0 (cement) ft. From 20 ft. to 0 (cement) ft.

What is the nearest source of possible contamination:

1 Septic tank

4 Lateral lines

7 Pit privy

10 Livestock pens

14 Abandoned water well

2 Sewer lines

5 Cess pool

8 Sewage lagoon

11 Fuel storage

15 Oil well/Gas well

3 Watertight sewer lines

6 Seepage pit

9 Feedyard

12 Fertilizer storage

16 Other (specify below)

13 Insecticide storage

Abdn. underground fuel

Direction from well?

NWHow many feet? 50

storage tank site

FROM	TO	LITHOLOGIC LOG	FROM	TO	PLUGGING INTERVALS
0	3	Top soil			
3	9	Clay-silty, sand, fine			
9	10	Sand- lt. brown			
10	16	Sand- VF, lt. brown			
16	18	Sand- VF lt. brown, moist			
18	20	Clay-dk brown, moist			
20	22	Clay - dk brown, dry			
22	25	Clay-silty, sandy VF.			
25	31.5	Clay-sandy, silty, dk. brown			
31.5	33.5	Clay-sandy			
33.5	37	Sand-med to coarse, silty			
37	37.5	Clay-sandy, brown			
37.5	40	Sand-fine-med, reddish brown			

CONTRACTOR'S OR LANDOWNER'S CERTIFICATION: This water well was (1) constructed (2) reconstructed, or (3) plugged under my jurisdiction and was completed on (mo/day/year) 3-15-91 and this record is true to the best of my knowledge and belief. KansasWater Well Contractor's License No. 527 This Water Well Record was completed on (mo/day/yr) 4-22-91Under the business name of GeoCore Services, Inc.by (signature) Dan Clark

INSTRUCTIONS: Use typewriter or ball point pen. PLEASE PRESS FIRMLY and PRINT clearly. Please fill in blanks, underline or circle the correct answers. Send top three copies to Kansas Department of Health and Environment, Bureau of Water, Topeka, Kansas 66620-7320. Telephone: 913-296-5545. Send one to WATER WELL OWNER and retain one for your records.