


LOCATION OF WATER WELL:	Fraction	Section Number	Township Number	Range Number
County: <u>Saline</u>	SW $\frac{1}{4}$ SW $\frac{1}{4}$ NW $\frac{1}{4}$	<u>30</u>	T <u>14</u> S	R <u>3</u> E 


distance and direction from nearest town or city street address of well if located within city?

#4 Red Fox Lane

WATER WELL OWNER: John Young
R#, St. Address, Box # : #4 Red Fox Lane
City, State, ZIP Code : Salina, Ks. 67401

Board of Agriculture, Division of Water Resources
Application Number:

LOCATE WELL'S LOCATION WITH AN "X" IN SECTION BOX: 4 DEPTH OF COMPLETED WELL: 52 ft. ELEVATION: 1100

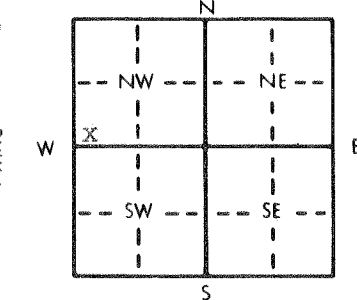

4 DEPTH OF COMPLETED WELL. 52. ft. ELEVATION: 1100

Depth(s) Groundwater Encountered 1. 21. ft. 2. ft. 3. ft.

WELL'S STATIC WATER LEVEL 21. ft. below land surface measured on mo/day/yr 7-23-86

Pump test data: Well water was 24m. ft. after 1 hours pumping 40 gpm

Est. Yield 80+ gpm: Well water was ft. after hours pumping gpm

Bore Hole Diameter. 8 1/2 in. to 48 ft., and in. to ft.

WELL WATER TO BE USED AS: 5 Public water supply 8 Air conditioning 11 Injection well

 X Domestic 3 Feedlot 6 Oil field water supply 9 Dewatering 12 Other (Specify below)

 2 Irrigation 4 Industrial 7 Lawn and garden only 10 Observation well X

Was a chemical/bacteriological sample submitted to Department? Yes. No. X; If yes, mo/day/yr sample was submitted

Water Well Disinfected? Yes X No

TYPE OF BLANK CASING USED:

1 Steel	3 RMP (SR)	5 Wrought iron	8 Concrete tile
2 PVC	4 ABS	6 Asbestos-Cement	9 Other (specify below)
		7 Fiberglass	

CASING JOINTS: Glued ☐ Clamped ☐
Welded ☐
Threaded ☐

Blank casing diameter 5 in. to 47 ft., Dia in. to ft., Dia in. to ft.

Casing height above land surface 12 in., weight 160 lbs./ft. Wall thickness or gauge No. SDR 26

TYPE OF SCREEN OR PERFORATION MATERIAL:			<input checked="" type="checkbox"/> PVC	<input type="checkbox"/> 10 Asbestos-cement
<input type="checkbox"/> 1 Steel	<input type="checkbox"/> 3 Stainless steel	<input type="checkbox"/> 5 Fiberglass	<input type="checkbox"/> 8 RMP (SR)	<input type="checkbox"/> 11 Other (specify)
<input type="checkbox"/> 2 Brass	<input type="checkbox"/> 4 Galvanized steel	<input type="checkbox"/> 6 Concrete tile	<input type="checkbox"/> 9 ABS	<input type="checkbox"/> 12 None used (open hole)

SCREEN OR PERFORATION OPENINGS ARE:

1 Continuous slot	3 Mill slot	5 Gauzed wrapped	8 Saw cut	11 None (open hole)
2 Louvered shutter	4 Key punched	6 Wire wrapped	9 Drilled holes	
		7 Torch cut	10 Other (specify)	

SCREEN-PERFORATED INTERVALS: From 47 ft. to 52 ft. From ft. to ft.
From ft. to ft. From ft. to ft.
GRAVEL PACK INTERVALS: From none ft. to ft. From ft. to ft.
From ft. to ft. From ft. to ft.

GROUT MATERIAL: 1x Neat cement 2 Cement grout 3 Bentonite 4 Other

Grout Intervals: From 5 ft. to 15 ft. From ft. to ft. From ft. to ft.

What is the nearest source of possible contamination:

1 Septic tank	4 Lateral lines	7 Pit privy	10 Livestock pens	14 Abandoned water well
2 Sewer lines	5 Cess pool	8 Sewage lagoon	11 Fuel storage	15 Oil well/Gas well
3 Watertight sewer lines	6 Seepage pit	9 Feedyard	12 Fertilizer storage	16 Other (specify below)
			13 Insecticide storage

Direction from well? North

How many feet? 60

[illegible]

CONTRACTOR'S OR LANDOWNER'S CERTIFICATION: This water well was (1) constructed, (2) reconstructed, or (3) plugged under my jurisdiction and was completed on (mo/day/year) 7-24-86 and this record is true to the best of my knowledge and belief. Kansas Water Well Contractor's License No. 388 This Water Well Record was completed on (mo/day/yr) 7-25-86 under the business name of Pestinger Pump Service by (signature) Paul Pestinger

INSTRUCTIONS: Use typewriter or ball point pen, PLEASE PRESS FIRMLY and PRINT clearly. Please fill in blanks, underline or circle the correct answers. Send top three copies to Kansas Department of Health and Environment, Division of Environment, Environmental Geology Section, Topeka, KS 66620. Send one to WATER WELL OWNER and retain one for your records.