

1 LOCATION OF WATER WELL:	Fraction	Section Number	Township Number	Range Number
County: <u>Saline</u>	<u>NW 1/4 NW 1/4 SE 1/4</u>	<u>36</u>	T <u>14</u> S	R <u>3</u> E <u>N</u>

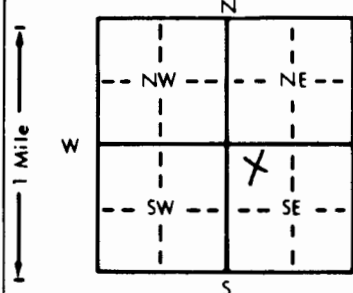
Distance and direction from nearest town or city street address of well if located within city?

700 NEAL

2 WATER WELL OWNER:	Board of Agriculture, Division of Water Resources
RR#, St. Address, Box # :	Application Number:
City, State, ZIP Code :	

Robert Kruse700 NEALSalina, KS 67401

3 LOCATE WELL'S LOCATION WITH AN "X" IN SECTION BOX:	4 DEPTH OF COMPLETED WELL: <u>58</u> ft. ELEVATION: <u>1241</u>
--	---


WELL WATER TO BE USED AS: 5 Public water supply 8 Air conditioning 11 Injection well

1 Domestic 3 Feedlot 6 Oil field water supply 9 Dewatering 12 Other (Specify below)

2 Irrigation 4 Industrial 7 Lawn and garden only 10 Monitoring wellWas a chemical/bacteriological sample submitted to Department? Yes X No X; If yes, mo/day/yr sample was submittedWater Well Disinfected? Yes X No

5 TYPE OF BLANK CASING USED:	5 Wrought iron	8 Concrete tile	CASING JOINTS: Glued <u>X</u> Clamped
1 Steel	3 RMP (SR)	9 Other (specify below)	Welded
<u>2</u> PVC	4 ABS	7 Fiberglass	Threaded


TYPE OF SCREEN OR PERFORATION MATERIAL:	<u>7</u> PVC	10 Asbestos-cement
1 Steel	3 Stainless steel	5 Fiberglass
2 Brass	4 Galvanized steel	6 Concrete tile
		8 RMP (SR)
		9 ABS
		11 Other (specify)
		12 None used (open hole)

SCREEN OR PERFORATION OPENINGS ARE: 5 Gauzed wrapped 8 Saw cut 11 None (open hole)

1 Continuous slot 3 Mill slot 6 Wire wrapped 9 Drilled holes

2 Louvered shutter 4 Key punched 7 Torch cut 10 Other (specify)

SCREEN-PERFORATED INTERVALS: From 50 ft. to 58 ft. From 50 ft. to 58 ft.From 50 ft. to 58 ft. From 50 ft. to 58 ft.GRAVEL PACK INTERVALS: From 22 ft. to 58 ft. From 22 ft. to 58 ft.7 CONTRACTOR'S OR LANDOWNER'S CERTIFICATION: This water well was 1 constructed, (2) reconstructed, or (3) plugged under my jurisdiction and wascompleted on (mo/day/year) 9-15-90 and this record is true to the best of my knowledge and belief. KansasWater Well Contractor's License No. 523 This Water Well Record was completed on (mo/day/yr) 9-23-90under the business name of Ma D Well Service by (signature) Matthew Loukup

INSTRUCTIONS: Use typewriter or ball point pen. PLEASE PRESS FIRMLY and PRINT clearly. Please fill in blanks, underline or circle the correct answers. Send top three copies to Kansas Department of Health and Environment, Bureau of Water, Topeka, Kansas 66620-7320. Telephone: 913-296-5545. Send one to WATER WELL OWNER and retain one for your records.