

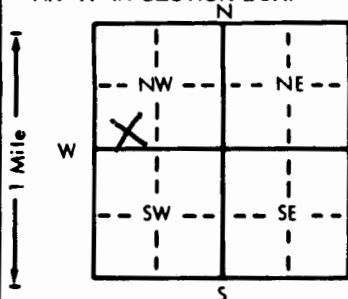
1 LOCATION OF WATER WELL: County: <u>SALINE</u>	Fraction <u>SE 1/4 SW 1/4 NW 1/4</u>	Section Number <u>36</u>	Township Number <u>T 14 N</u>	Range Number <u>R 3 E</u>
--	---	-----------------------------	----------------------------------	------------------------------

Distance and direction from nearest town or city street address of well if located within city?

2657 Summer Lane

2 WATER WELL OWNER: RR#, St. Address, Box #: City, State, ZIP Code	<u>Gail KONZEM</u> <u>2657 Summer Lane</u> <u>SALINA KANSAS 67401</u>	Board of Agriculture, Division of Water Resources Application Number: <u>1240</u>
--	---	---

3 LOCATE WELL'S LOCATION WITH AN "X" IN SECTION BOX:	4 DEPTH OF COMPLETED WELL: <u>57 1/2</u> ft. ELEVATION: <u>1240</u>
--	---

Depth(s) Groundwater Encountered 1. 29 ft. 2. _____ ft. 3. _____ ft.

WELL'S STATIC WATER LEVEL _____ ft. below land surface measured on mo/day/yr

Pump test data: Well water was _____ ft. after _____ hours pumping _____ gpm

Est. Yield 35 gpm: Well water was 34 ft. after 1 hours pumping 25 gpmBore Hole Diameter: 8 1/2 in. to 29 ft., and 5 1/2 in. to 57 1/2 ft.

WELL WATER TO BE USED AS: 5 Public water supply 8 Air conditioning 11 Injection well

1 Domestic 3 Feedlot 6 Oil field water supply 9 Dewatering 12 Other (Specify below)

2 Irrigation 4 Industrial ⑦ Lawn and garden only 10 Monitoring well

Was a chemical/bacteriological sample submitted to Department? Yes _____ No X; If yes, mo/day/yr sample was submitted _____
Water Well Disinfected? Yes X No _____

5 TYPE OF BLANK CASING USED:	5 Wrought iron	8 Concrete tile	CASING JOINTS: Glued <u>X</u> Clamped _____
1 Steel	3 RMP (SR)	6 Asbestos-Cement	9 Other (specify below)
② PVC	4 ABS	7 Fiberglass	Welded _____
Blank casing diameter <u>5</u> in. to <u>47 1/2</u> ft. Dia _____ in. to _____ ft. Dia _____ in. to _____ ft.			Threaded _____

Casing height above land surface _____ in., weight 160 lb. lbs./ft. Wall thickness or gauge No. SDR 26

TYPE OF SCREEN OR PERFORATION MATERIAL:	⑦ PVC	10 Asbestos-cement
1 Steel	3 Stainless steel	8 RMP (SR)
2 Brass	4 Galvanized steel	11 Other (specify) _____
5 Fiberglass	6 Concrete tile	12 None used (open hole)

SCREEN OR PERFORATION OPENINGS ARE:	5 Gauzed wrapped	8 Saw cut	11 None (open hole)
1 Continuous slot	③ Mill slot	6 Wire wrapped	9 Drilled holes
2 Louvered shutter	4 Key punched	7 Torch cut	10 Other (specify) _____

SCREEN-PERFORATED INTERVALS:	From <u>47 1/2</u> ft. to <u>57 1/2</u> ft.	From _____ ft. to _____ ft.	From _____ ft. to _____ ft.
GRAVEL PACK INTERVALS:	From <u>20</u> ft. to <u>57 1/2</u> ft.	From _____ ft. to _____ ft.	From _____ ft. to _____ ft.

6 GROUT MATERIAL:	① Neat cement	2 Cement grout	3 Bentonite	4 Other _____
Grout Intervals: From _____ ft. to <u>20</u> ft.				

What is the nearest source of possible contamination:	10 Livestock pens	14 Abandoned water well
1 Septic tank	4 Lateral lines	7 Pit privy
2 Sewer lines	5 Cess pool	8 Sewage lagoon
③ Watertight sewer lines	6 Seepage pit	9 Feedyard
		11 Fuel storage
		12 Fertilizer storage
		13 Insecticide storage
		15 Oil well/Gas well
		16 Other (specify below) _____

Direction from well? NORTH & EAST How many feet? 16' + 16'

FROM	TO	LITHOLOGIC LOG	FROM	TO	PLUGGING INTERVALS
0'	2'	Compacted dirt & silt			
2'	5'	Hard dark clay			
5'	14'	FINE SAND & clay mixed			
14'	17'	FINE SAND			
17'	19'	Brown clay			
19'	40'	FINE SAND & clay mixed			
40'	57 1/2'	medium to coarse SAND & GRAVEL			
57 1/2'		DARK BROWN CLAY			

7 CONTRACTOR'S OR LANDOWNER'S CERTIFICATION: This water well was ① constructed, (2) reconstructed, or (3) plugged under my jurisdiction and was completed on (mo/day/year) <u>5-18-92</u> and this record is true to the best of my knowledge and belief. Kansas Water Well Contractor's License No. <u>523</u> This Water Well Record was completed on (mo/day/yr) <u>5-18-92</u> under the business name of <u>M & D Well Service</u> by (signature) <u>Matthew Louie</u>
