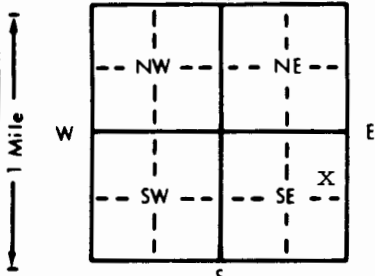


1 LOCATION OF WATER WELL:	Fraction	Section Number	Township Number	Range Number
County: Saline	SE ¼ NE ¼ SE ¼	36	T 14 S	R 3 E/W

Distance and direction from nearest town or city street address of well if located within city?

1 mile East of 9th to Ohio st. Ohio St. South 3/4 mile

2 WATER WELL OWNER:	Stevens contractors	Board of Agriculture, Division of Water Resources
RR#, St. Address, Box # :	P.O. Box 6197	Application Number:
City, State, ZIP Code :	Salina, Ks. 67401-0197	

3 LOCATE WELL'S LOCATION WITH AN "X" IN SECTION BOX:	4 DEPTH OF COMPLETED WELL: 50 ft. ELEVATION:
	Depth(s) Groundwater Encountered 1. 15 ft. 2. 30 ft. 3. 30 ft. 4. 30 ft.
	WELL'S STATIC WATER LEVEL 15 ft. below land surface measured on mo/day/yr 3-15-93
	Pump test data: Well water was 15 ft. after 3 hours pumping 3 gpm
	Est. Yield 3 gpm: Well water was 15 ft. after 3 hours pumping 3 gpm
	Bore Hole Diameter 28 in. to 50 ft., and 50 in. to 50 ft.
	WELL WATER TO BE USED AS:
	1 Domestic 3 Feedlot 6 Oil field water supply 9 Dewatering 12 Other (Specify below)
	2 Irrigation 4 Industrial 7 Lawn and garden only 10 Monitoring well
	Was a chemical/bacteriological sample submitted to Department? Yes No X If yes, mo/day/yr sample was submitted
	Water Well Disinfected? Yes No X

5 TYPE OF BLANK CASING USED:	5 Wrought iron	8 Concrete tile	CASING JOINTS: Glued X Clamped
1 Steel	3 RMP (SR)	6 Asbestos-Cement	9 Other (specify below)
2 PVC	4 ABS	7 Fiberglass	10 Asbestos-cement
Blank casing diameter 16 in. to 20 ft. Dia			11 Other (specify)
Casing height above land surface 12 in. weight			12 None used (open hole)
TYPE OF SCREEN OR PERFORATION MATERIAL:	7 PVC		
1 Steel	3 Stainless steel	5 Fiberglass	8 RMP (SR)
2 Brass	4 Galvanized steel	6 Concrete tile	9 ABS
SCREEN OR PERFORATION OPENINGS ARE:	5 Gauzed wrapped	8 Saw cut	11 None (open hole)
1 Continuous slot	3 Mill slot	6 Wire wrapped	9 Drilled holes
2 Louvered shutter	4 Key punched	7 Torch cut	10 Other (specify)
SCREEN-PERFORATED INTERVALS:	From 20 ft. to 50 ft.		
GRAVEL PACK INTERVALS:	From 50 ft. to 15 ft.		

6 GROUT MATERIAL:	1 Neat cement	2 Cement grout	3 Bentonite	4 Other None
Grout intervals:	From 0 ft. to 0 ft.			
What is the nearest source of possible contamination:				
1 Septic tank	4 Lateral lines	7 Pit privy	10 Livestock pens	14 Abandoned water well
2 Sewer lines	5 Cess pool	8 Sewage lagoon	11 Fuel storage	15 Oil well/Gas well
3 Watertight sewer lines	6 Seepage pit	9 Feedyard	12 Fertilizer storage	16 Other (specify below)
			13 Insecticide storage	None

Direction from well?	How many feet?				
FROM	TO	LITHOLOGIC LOG	FROM	TO	PLUGGING INTERVALS
0	3	Top soil			
3	22	Clay dark			
22	25	Soft clay & sand mixed			
25	41	Sand & gravel			
41	42½	Clay			
42½	50	Sand & gravel			

7 CONTRACTOR'S OR LANDOWNER'S CERTIFICATION:	This water well was (1) constructed, (2) reconstructed, or (3) plugged under my jurisdiction and was completed on (mo/day/year) 3-15-93 and this record is true to the best of my knowledge and belief. Kansas
Water Well Contractor's License No. 134	This Water Well Record was completed on (mo/day/yr) 3-19-93
under the business name of Rosencrantz-Bemis	by (signature) Greg Dodson