


1 LOCATION OF WATER WELL:		Fraction				Section Number		Township Number		Range Number				
County:	Saline	SW	1/4	SW	1/4	SW	1/4	33	T	14	S	R	3	EW

2] WATER WELL OWNER:	Salina Airport Authority - Corp of Engineers	
RR#, St. Address, Box # :	3237 Arnold Rd.	Board of Agriculture, Division of Water Resources
City, State, ZIP Code :	Salina, Kansas 67401	Application Number:

4 DEPTH OF COMPLETED WELL.....26..... ft. ELEVATION:

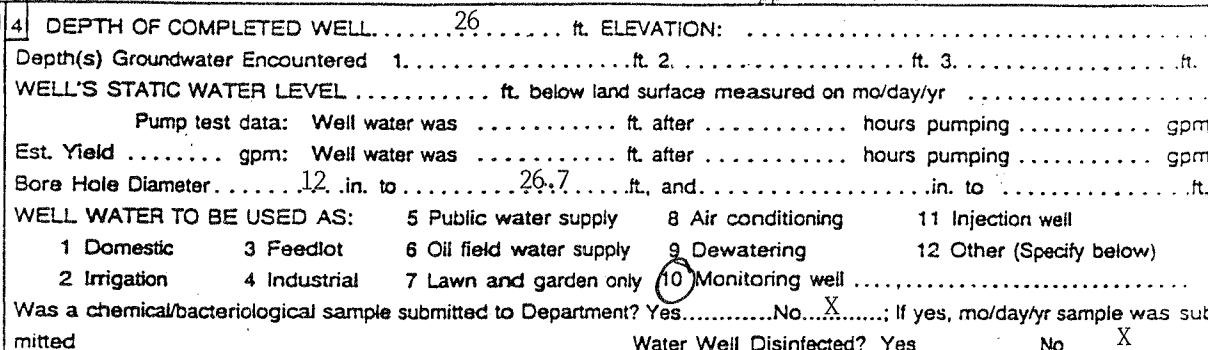

Blank casing diameter 2 . . . in. to . . . ft., Dia in. to . . . ft., Dia in. to . . . ft.
Casing height above land surface 36 . . . in., weight lbs./ft. Wall thickness or gauge No. sch. 40

SCREEN OR PERFORATION OPENINGS ARE:

1 Continuous slot	3 Mill slot	5 Gauzed wrapped	8 Saw cut	11 None (open hole)
2 Louvered shutter	4 Key punched	6 Wire wrapped	9 Drilled holes	
		7 Torch cut	10 Other (specify)	

6 GROUT MATERIAL: 1 Neat cement 2 Cement grout 3 Bentonite 4 Other
Grout Intervals: From 7 ft. to 3.5 ft. From 3.5 ft. to 0 ft. From ft. to ft.

What is the nearest source of possible contamination:

1 Septic tank	4 Lateral lines	7 Pit privy	10 Livestock pens	14 Abandoned water well
2 Sewer lines	5 Cess pool	8 Sewage lagoon	11 Fuel storage	15 Oil well/Gas well
3 Watertight sewer lines	6 Seepage pit	9 Feedyard	12 Fertilizer storage	16 Other (specify below)
			13 Insecticide storage	unknown

Direction from well? unknown

How many feet?

[illegible]

7. CONTRACTOR'S OR LANDOWNER'S CERTIFICATION: This water well was (1) constructed, (2) reconstructed, or (3) plugged under my jurisdiction and was completed on (mo/day/year) 04-22-93 and this record is true to the best of my knowledge and belief. Kansas Water Well Contractor's License No. 527 This Water Well Record was completed on (mo/day/yr) 07-15-94 under the business name of GebCore Services, Inc. by (signature) *Dale Ell*