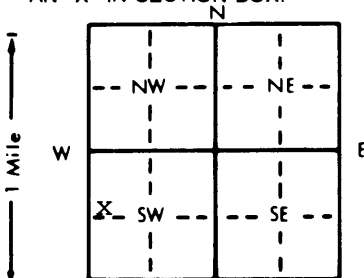


1 LOCATION OF WATER WELL:		Fraction	Section Number	Township Number	Range Number
County: SALINE		SW 1/4 NW 1/4 SW 1/4	24	T 14 S	R 3 E
Distance and direction from nearest town or city street address of well if located within city?					
1513 S. 9th SALINA KS 67401					
2 WATER WELL OWNER: SINCLAIR MARKETING CO					
RR#, St. Address, Box # : P.O. BOX 6247			Board of Agriculture, Division of Water Resources		
City, State, ZIP Code : KS, CITY, KS 66106			Application Number:		
3 LOCATE WELL'S LOCATION WITH AN "X" IN SECTION BOX:		4 DEPTH OF COMPLETED WELL: 37 ft. ELEVATION:			
		Depth(s) Groundwater Encountered 128 ft. 2. ft. 3. ft.			
		WELL'S STATIC WATER LEVEL 28 ft. below land surface measured on mo/day/yr			
		Pump test data: Well water was ft. after hours pumping gpm			
		Est. Yield gpm: Well water was ft. after hours pumping gpm			
		Bore Hole Diameter 7 1/4 in. to 37 ft., and in. to ft.			
		WELL WATER TO BE USED AS: 5 Public water supply 8 Air conditioning 11 Injection well			
		1 Domestic 3 Feedlot 6 Oil field water supply 9 Dewatering 12 Other (Specify below)			
		2 Irrigation 4 Industrial 7 Lawn and garden only 10 Monitoring well			
		Was a chemical/bacteriological sample submitted to Department? Yes No; If yes, mo/day/yr sample was submitted			
		Water Well Disinfected? Yes No			
5 TYPE OF BLANK CASING USED:					
1 Steel		3 RMP (SR)	5 Wrought iron	8 Concrete tile	CASING JOINTS: Glued Clamped
2 PVC		4 ABS	6 Asbestos-Cement	9 Other (specify below)	Welded
			7 Fiberglass		Threaded X
Blank casing diameter 2 in. to 22 ft., Dia in. to ft., Dia in. to ft.					
Casing height above land surface 0.6 in., weight sched. 40 lbs./ft. Wall thickness or gauge No.					
TYPE OF SCREEN OR PERFORATION MATERIAL:					
1 Steel		3 Stainless steel	5 Fiberglass	8 RMP (SR)	10 Asbestos-cement
2 Brass		4 Galvanized steel	6 Concrete tile	9 ABS	11 Other (specify)
					12 None used (open hole)
SCREEN OR PERFORATION OPENINGS ARE:					
1 Continuous slot		3 Mill slot	5 Gauzed wrapped	8 Saw cut	11 None (open hole)
2 Louvered shutter		4 Key punched	6 Wire wrapped	9 Drilled holes	
			7 Torch cut	10 Other (specify)	
SCREEN-PERFORATED INTERVALS: From 37 ft. to 22 ft., From ft. to ft.					
GRAVEL PACK INTERVALS: From 37 ft. to 21 ft., From ft. to ft.					
6 GROUT MATERIAL:					
1 Neat cement		2 Cement grout	3 Bentonite	4 Other	
Grout Intervals: From 20 ft. to 0.6 ft., From ft. to ft., From ft. to ft.					
What is the nearest source of possible contamination:					
1 Septic tank		4 Lateral lines	7 Pit privy	10 Livestock pens	14 Abandoned water well
2 Sewer lines		5 Cess pool	8 Sewage lagoon	11 Fuel storage	15 Oil well/Gas well
3 Watertight sewer lines		6 Seepage pit	9 Feedyard	12 Fertilizer storage	16 Other (specify below)
13 Insecticide storage					
Direction from well? W		How many feet? 150			
FROM TO		LITHOLOGIC LOG		FROM TO PLUGGING INTERVALS	
0	3	TOPSOIL			
3	5	brn CLAY			
5	22	" "			
22	29	TAN BRN CLAY			
29	34	TAN BRN SANDY CLAY SATURATED @ 30.0			
34	37	TAN GREY SANDY CLAY			
7 CONTRACTOR'S OR LANDOWNER'S CERTIFICATION: This water well was (1) constructed, (2) reconstructed, or (3) plugged under my jurisdiction and was completed on (mo/day/year) 11-16-94 and this record is true to the best of my knowledge and belief. Kansas Water Well Contractor's License No. 575 This Water Well Record was completed on (mo/day/yr) 12-12-94 under the business name of KURTZ ENVIRONMENTAL SERVICE by (signature)					
INSTRUCTIONS: Use typewriter or ball point pen. PLEASE PRESS FIRMLY and PRINT clearly. Please fill in blanks, underline or circle the correct answers. Send top three copies to Kansas Department of Health and Environment, Bureau of Water, Topeka, Kansas 66620-0001. Telephone: 913-296-5545. Send one to WATER WELL OWNER and retain one for your records.					