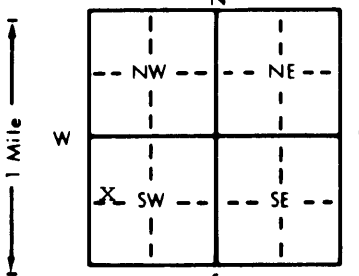


1 LOCATION OF WATER WELL:		Fraction	Section Number	Township Number	Range Number
County: <u>SALINE</u>		<u>SW</u> $\frac{1}{4}$ <u>NW</u> $\frac{1}{4}$ <u>SW</u> $\frac{1}{4}$	<u>24</u>	<u>T</u> <u>14</u> <u>S</u>	<u>R</u> <u>3</u> <u>E/W</u>
Distance and direction from nearest town or city street address of well if located within city?					
<u>1513 S. 9th SALINA, Ks</u>					
2 WATER WELL OWNER: <u>SINCLAIR MARKETING CO.</u>					
RR#, St. Address, Box #: <u>P.O. BOX 6247</u>					
City, State, ZIP Code: <u>KS, CITY KS</u>					
Board of Agriculture, Division of Water Resources					
Application Number:					
3 LOCATE WELL'S LOCATION WITH AN "X" IN SECTION BOX:		4 DEPTH OF COMPLETED WELL: <u>35</u> ft. ELEVATION:			
		Depth(s) Groundwater Encountered <u>1</u> ft. 2. ft. 3. ft.			
		WELL'S STATIC WATER LEVEL <u>999</u> ft. below land surface measured on mo/day/yr			
		Pump test data: Well water was ft. after hours pumping gpm			
		Est. Yield gpm: Well water was ft. after hours pumping gpm			
		Bore Hole Diameter <u>7 1/4</u> in. to <u>35</u> ft., and in. to ft.			
		WELL WATER TO BE USED AS: 5 Public water supply 8 Air conditioning 11 Injection well			
		1 Domestic 3 Feedlot 6 Oil field water supply 9 Dewatering 12 Other (Specify below)			
		2 Irrigation 4 Industrial 7 Lawn and garden only 10 Monitoring well			
		Was a chemical/bacteriological sample submitted to Department? Yes No <u>X</u> ; If yes, mo/day/yr sample was submitted			
		Water Well Disinfected? Yes No			
5 TYPE OF BLANK CASING USED:					
1 Steel 3 RMP (SR) 5 Wrought iron 8 Concrete tile CASING JOINTS: Glued Clamped					
X PVC 4 ABS 6 Asbestos-Cement 9 Other (specify below) Welded					
7 Fiberglass Threaded <u>X</u>					
Blank casing diameter <u>2</u> in. to <u>20</u> ft., Dia. in. to ft., Dia. in. to ft.					
Casing height above land surface <u>0.6</u> in., weight <u>schd. 40</u> lbs./ft. Wall thickness or gauge No.					
TYPE OF SCREEN OR PERFORATION MATERIAL: X PVC 10 Asbestos-cement					
1 Steel 3 Stainless steel 5 Fiberglass 8 RMP (SR) 11 Other (specify)					
2 Brass 4 Galvanized steel 6 Concrete tile 9 ABS 12 None used (open hole)					
SCREEN OR PERFORATION OPENINGS ARE:					
1 Continuous slot 5 Gauzed wrapped 8 Saw cut 11 None (open hole)					
X Mill slot 6 Wire wrapped 9 Drilled holes					
2 Louvered shutter 4 Key punched 7 Torch cut 10 Other (specify)					
SCREEN-PERFORATED INTERVALS: From <u>35</u> ft. to <u>20</u> ft., From ft. to ft.					
From ft. to ft., From ft. to ft.					
GRAVEL PACK INTERVALS: From <u>35</u> ft. to <u>18</u> ft., From ft. to ft.					
From ft. to ft., From ft. to ft.					
6 GROUT MATERIAL: 1 Neat cement X Cement grout 3 Bentonite 4 Other					
Grout Intervals: From <u>17</u> ft. to <u>0.6</u> ft., From ft. to ft., From ft. to ft.					
What is the nearest source of possible contamination:					
1 Septic tank 4 Lateral lines 7 Pit privy 10 Livestock pens 14 Abandoned water well					
2 Sewer lines 5 Cess pool 8 Sewage lagoon X 11 Fuel storage 15 Oil well/Gas well					
3 Watertight sewer lines 6 Seepage pit 9 Feedyard 12 Fertilizer storage 16 Other (specify below)					
13 Insecticide storage					
Direction from well? <u>SE</u> How many feet? <u>32</u>					
FROM TO LITHOLOGIC LOG FROM TO PLUGGING INTERVALS					
0	3	TOPSOIL			
3	5	BRN CLAY			
5	10	BRN CLAY			
10	15	BRN STIFF CLAY			
15	20	BRN TAN CLAY			
20	24	" " "			
24	32	SANDY TAN CLAY saturated @	24.0		
32	35	SILTY SANDY TAN GREY CLAY			
7 CONTRACTOR'S OR LANDOWNER'S CERTIFICATION: This water well was (X) constructed, (2) reconstructed, or (3) plugged under my jurisdiction and was completed on (mo/day/year) <u>11-16-94</u> and this record is true to the best of my knowledge and belief. Kansas Water Well Contractor's License No. <u>575</u> This Water Well Record was completed on (mo/day/yr) <u>12-12-94</u> under the business name of <u>KURTZ ENVIRONMENTAL SERVICE</u> by (signature) <u>[Signature]</u>					