


1 LOCATION OF WATER WELL: Fraction NW 1/4 SE 1/4 SE 1/4 Section Number 29 Township Number T 14 S Range Number R 32 EW

Distance and direction from nearest town or city street address of well if located within city?  
 20 miles South, 2 West, 1 North of Oakley, Ks.

2 WATER WELL OWNER: H.C. Rose  
 RR#, St. Address, Box # : 210 W. 9th St. Board of Agriculture, Division of Water Resources  
 City, State, ZIP Code : Scott City, Ks. 67871 Application Number:

3 LOCATE WELL'S LOCATION WITH AN "X" IN SECTION BOX:

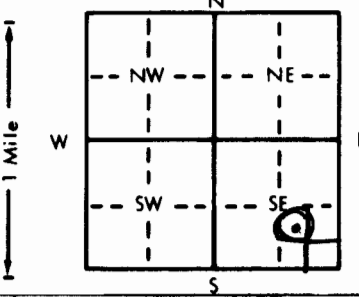

4 DEPTH OF COMPLETED WELL: 40' ft. ELEVATION:  
 Depth(s) Groundwater Encountered 1. 7' ft. 2. ft. 3. ft.  
 WELL'S STATIC WATER LEVEL: 7' ft. below land surface measured on mo/day/yr  
 Pump test data: Well water was ft. after hours pumping gpm  
 Est. Yield gpm: Well water was ft. after hours pumping gpm  
 Bore Hole Diameter: 14" in. to 40 ft., and in. to ft.  
 WELL WATER TO BE USED AS:  
 Domestic 3 Feedlot 6 Oil field water supply 9 Dewatering 12 Other (Specify below)  
 Irrigation 4 Industrial 7 Lawn and garden only 10 Monitoring well  
 Was a chemical/bacteriological sample submitted to Department? Yes No ; If yes, mo/day/yr sample was submitted  
 Water Well Disinfected? Yes  No

5 TYPE OF CASING USED:  
 1 Steel 3 RMP (SR) 6 Asbestos-Cement 9 Other (specify below) Welded  
 PVC 4 ABS 7 Fiberglass Threaded  
 Blank casing diameter 5" in. to 7' ft., Dia 5" in. to 28-40" ft., Dia in. to ft.  
 Casing height above land surface 24" in., weight lbs./ft. Wall thickness or gauge No. SCH. 40

TYPE OF SCREEN OR PERFORATION MATERIAL:  
 1 Steel 3 Stainless steel 5 Fiberglass 8 RMP (SR) 10 Asbestos-cement  
 2 Brass 4 Galvanized steel 6 Concrete tile 9 ABS 11 Other (specify)  
 PVC 12 None used (open hole)

SCREEN OR PERFORATION OPENINGS ARE:  
 1 Continuous slot  Mill slot 5 Gauzed wrapped 8 Saw cut 11 None (open hole)  
 2 Louvered shutter 4 Key punched 6 Wire wrapped 9 Drilled holes  
 7 Torch cut 10 Other (specify)

SCREEN-PERFORATED INTERVALS: From 7' ft. to 28' ft., From ft. to ft.  
 From ft. to ft., From ft. to ft.  
 GRAVEL PACK INTERVALS: From 6' ft. to 40' ft., From ft. to ft.  
 From ft. to ft., From ft. to ft.

6 GROUT MATERIAL: 1 Neat cement 2 Cement grout  Bentonite 4 Other  
 Grout Intervals: From 0 ft. to 6' ft., From ft. to ft., From ft. to ft.

What is the nearest source of possible contamination:  
 1 Septic tank 4 Lateral lines 7 Pit privy 10 Livestock pens 14 Abandoned water well  
 2 Sewer lines 5 Cess pool 8 Sewage lagoon 11 Fuel storage 15 Oil well/Gas well  
 3 Watertight sewer lines 6 Seepage pit 9 Feedyard 12 Fertilizer storage  Other (specify below)  
 13 Insecticide storage Smoky Hill River  
 Direction from well? North How many feet? 150'

FROM	TO	LITHOLOGIC LOG	FROM	TO	PLUGGING INTERVALS
0	1	Top Soil			
1	9	Coarse Sand, Large Gravel			
9	40	Shale			
	40	Total Depth of Well			

7 CONTRACTOR'S OR LANDOWNER'S CERTIFICATION: This water well was  constructed, (2) reconstructed, or (3) plugged under my jurisdiction and was completed on (mo/day/year) 01-03-90 and this record is true to the best of my knowledge and belief. Kansas Water Well Contractor's License No. #514 This Water Well Record was completed on (mo/day/yr) 01-04-90 under the business name of Miller Gearhead & Pump Repair, Inc. by (signature) Everett Miller