

USE TYPEWRITER OR BALL POINT PEN-PRESS FIRMLY, PRINT CLEARLY.


WATER WELL RECORD
KSA 82a-1201-1215

Kansas Department of Health and Environment-Division of Environment
(Water well Contractors)
Topeka, Kansas 66620

444

1. Location of well: County **Wallace** Fraction **NE 1/4 NE 1/4 NE 1/4** Section number **30** Township number **T 14 S R 30 E/W** Range number

2. Distance and direction from nearest town or city: **7 S. 1 E. of Wallace**
Street address of well location if in city:
3. Owner of well: **Ila Lowe**
R.R. or street: **Wallace, Kansas 67761**
City, state, zip code:

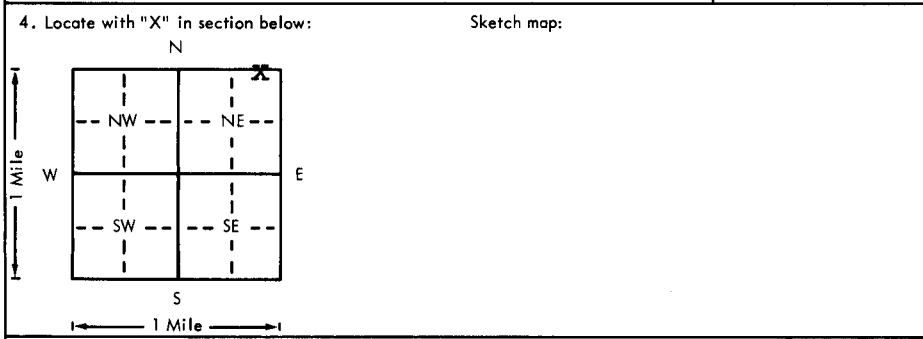

6. Bore hole dia. **8** in. Completion date **5/10/78**
Well depth **140** ft.
7. Cable tool Rotary Driven Dug
 Hollow rod Jetted Bored Reverse rotary
8. Use: Domestic Public supply Industry
 Irrigation Air conditioning Stock
 Lawn Oil field water Other
9. Casing: Material **plst** Height: Above or below
Threaded Welded **gl** Surface **15** in.
RMP PVC Weight _____ lbs./ft.
Dia. **5** in. to **140** ft. depth Wall Thickness: inches or
Dia. _____ in. to _____ ft. depth gage No. **.250**

5. Type and color of material	From	To
Top Soil	0	27
Sand Rock and Sand Strips	27	66
Sand and Sand Rock Strips	66	91
Sand	91	98
Sand Rock	98	101
Sand	101	114
Sand Clay and Strips of Sand	114	121
Sand and Sand Rock Strips	121	138
Oker and Shale	138	140
BROCK 138'		

10. Screen: Manufacturer's name **J&L**
Type **RMP** Dia. **5"**
Slot/gauze **.032** Length **20'**
Set between **120** ft. and **140** ft.
_____ ft. and _____ ft.
Gravel pack? **yes** Size range of material **1/8"**
11. Static water level: _____ mo./day/yr.
100 ft. below land surface Date _____
12. Pumping level below land surfaces:
_____ ft. after **n.a.** hrs. pumping _____ g.p.m.
_____ ft. after _____ hrs. pumping _____ g.p.m.
Estimated maximum yield _____ g.p.m.
13. Water sample submitted: _____ mo./day/yr.
Yes No Date _____
14. Well head completion:
 Pitless adapter **20** Inches above grade
15. Well grouted? **yes**
With: Neat cement Bentonite Concrete
Depth: From **4** ft. to **218** ft.
16. Nearest source of possible contamination:
ft. _____ Direction **n.a.** Type _____
Well disinfected upon completion? Yes No
17. Pump: _____ Not installed
Manufacturer's name _____
Model number _____ HP **3/4** Volts **230**
Length of drop pipe **120** ft. capacity _____ g.p.m.
Type:
 Submersible _____ Turbine
 Jet _____ Reciprocating
 Centrifugal _____ Other _____

18. Elevation:
Topography:
 Hill
 Slope
 Upland
 Valley
19. Remarks:
Pump installed was an old pump the customer had on hand that worked okay.

20. Water well contractor's certification:
This well was drilled under my jurisdiction and this report is true to the best of my knowledge and belief.
Bartell Drilling **139**
Business name License No.
Address **Winona, Kansas 67764**
Signed **Joyce Bartell** Date **7/7/78**
Authorized representative

