


USE TYPEWRITER OR BALL POINT PEN-PRESS FIRMLY, PRINT CLEARLY.

WATER WELL RECORD  
KSA 82a-1201-1215  
**CCC**

Kansas Department of Health and Environment-Division of Environment  
(Water well Contractors)  
Topeka, Kansas 66620

1. Location of well:	County <b>Wallace</b>	Fraction <b>SW 1/4 SW 1/4 SW 1/4</b>	Section number <b>33</b>	Township number <b>T 14 S</b>	Range number <b>R 38 W E/W</b>
----------------------	--------------------------	---	-----------------------------	----------------------------------	-----------------------------------

2. Distance and direction from nearest town or city: <b>9 mi. S., &amp; 2 E. of Wallace, Kansas</b> Street address of well location if in city:	3. Owner of well: <b>Floyd Buell</b> R.R. or street: <b>Rt. 1</b> City, state, zip code: <b>Wallace, Kans. 67761</b>
--	--

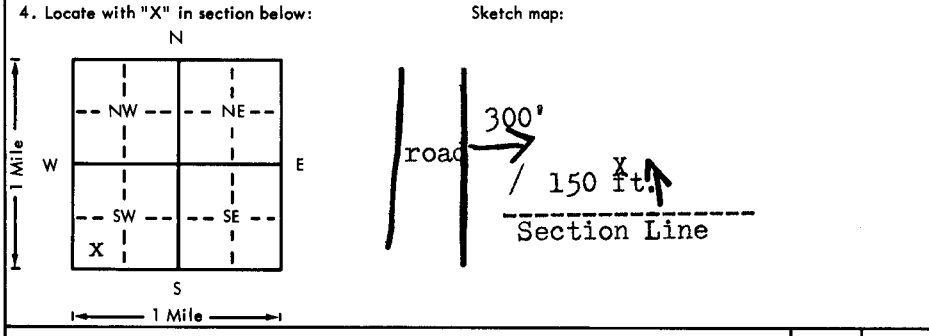

5. Type and color of material	From	To
Top soil	0	15
Limestone	15	50
Sand	50	65
Clay	65	90
Sand	90	105
Clay & Shale	105	110
<b>BROCK 107</b>		
(Use a second sheet if needed)		

6. Bore hole dia. <u>6</u> in. Completion date _____ Well depth <u>110</u> ft. <u>9-20-79</u>
7. <input checked="" type="checkbox"/> Cable tool <input type="checkbox"/> Rotary <input type="checkbox"/> Driven <input type="checkbox"/> Dug <input type="checkbox"/> Hollow rod <input type="checkbox"/> Jetted <input type="checkbox"/> Bored <input type="checkbox"/> Reverse rotary
8. Use: <input checked="" type="checkbox"/> Domestic <input type="checkbox"/> Public supply <input type="checkbox"/> Industry <input type="checkbox"/> Irrigation <input type="checkbox"/> Air conditioning <input type="checkbox"/> Stock <input type="checkbox"/> Lawn <input type="checkbox"/> Oil field water <input type="checkbox"/> Other
9. Casing: Material <u>Steel</u> Height: Above ground _____ Threaded _____ Welded <input checked="" type="checkbox"/> Surface <u>18"</u> in. RMP _____ PVC _____ Weight <u>188x</u> lbs./ft. Dia. <u>5</u> in. to <u>95</u> ft. depth Wall Thickness: inches or Dia. _____ in. to _____ ft. depth Gauge No. <u>188</u>
10. Screen: Manufacturer's name _____ Type <u>Perf. casing</u> Dia. <u>5"</u> Slot/gauze <u>slot</u> Length <u>15'</u> Set between <u>95'</u> ft. and <u>110'</u> ft. _____ ft. and _____ ft. Gravel pack? <input checked="" type="checkbox"/> <u>yes</u> Size range of material <u>3/8"</u>
11. Static water level: _____ mo./day/yr. <u>80</u> ft. below land surface Date <u>9-20-79</u>
12. Pumping level below land surfaces: <u>109</u> ft. after <u>2</u> hrs. pumping <u>15</u> g.p.m. _____ ft. after _____ hrs. pumping _____ g.p.m. Estimated maximum yield <u>15</u> g.p.m.
13. Water sample submitted: _____ mo./day/yr. Yes <input type="checkbox"/> No <input checked="" type="checkbox"/> Date _____
14. Well head completion: _____ <input type="checkbox"/> Pitless adapter <u>18</u> inches above grade
15. Well grouted? <u>yes</u> With: <input type="checkbox"/> Neat cement <input checked="" type="checkbox"/> Bentonite _____ Concrete _____ Depth: From <u>0</u> ft. to <u>20</u> ft.
16. Nearest source of possible contamination: ft. _____ Direction _____ Type <u>None</u> Well disinfected upon completion? <input checked="" type="checkbox"/> Yes _____ No _____
17. Pump: <input checked="" type="checkbox"/> _____ Not installed Manufacturer's name _____ Model number _____ HP _____ Volts _____ Length of drop pipe _____ ft. capacity _____ g.p.m. Type: <input type="checkbox"/> Submersible <input type="checkbox"/> Turbine <input type="checkbox"/> Jet <input type="checkbox"/> Reciprocating <input type="checkbox"/> Centrifugal <input type="checkbox"/> Other

18. Elevation:	19. Remarks:
Topography: <input type="checkbox"/> Hill <input type="checkbox"/> Slope <input type="checkbox"/> Upland <input type="checkbox"/> Valley	

20. Water well contractor's certification: This well was drilled under my jurisdiction and this report is true to the best of my knowledge and belief.	
<b>Ark Valley Pump &amp; Supply 123</b>	
Business name	License No.
Address <u>Box 235 Holly, Colo.</u>	
Signed <u>Wm Smith</u>	Date <u>10-30</u>
Authorized representative	

17- 38E  
 33  
 SUSPENDED  
 1/4 1/4 1/4