


WATER WELL RECORD Form WWC-5 KSA 82a-1212

1) LOCATION OF WATER WELL: County: Wallace Fraction: NE 1/4 SW 1/4 SW 1/4 Section Number: 9 Township Number: T 14 S Range Number: R 39 EW

Distance and direction from nearest town or city street address of well if located within city?
4.5 East + 2.75 South of Sharon Springs

2) WATER WELL OWNER: Marion Ruhlman
 RR#, St. Address, Box # :
 City, State, ZIP Code : Sharon Springs, Ks. 67758 Board of Agriculture, Division of Water Resources Application Number:

3) LOCATE WELL'S LOCATION WITH AN "X" IN SECTION BOX:

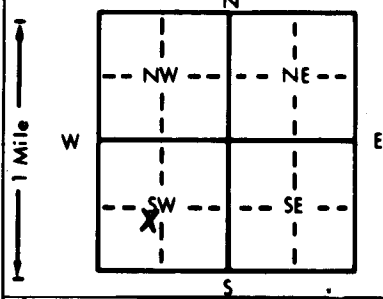

4) DEPTH OF COMPLETED WELL: 28 ft. ELEVATION: 3500
 Depth(s) Groundwater Encountered 1. 13 ft. 2. ft. 3. ft.
 WELL'S STATIC WATER LEVEL 13 ft. below land surface measured on mo/day/yr 11-15-87
 Pump test data: Well water was 15 ft. after 1 hours pumping 5 gpm
 Est. Yield 6 gpm Well water was ft. after hours pumping gpm
 Bore Hole Diameter 8 in. to 28 ft., and in. to ft.
 WELL WATER TO BE USED AS:
 1 Domestic 3 Feedlot 6 Oil field water supply 9 Dewatering 12 Other (Specify below)
 2 Irrigation 4 Industrial 7 Lawn and garden only 10 Observation well
 Was a chemical/bacteriological sample submitted to Department? Yes.....No ; If yes, mo/day/yr sample was submitted
 Water Well Disinfected? Yes No

5) TYPE OF BLANK CASING USED:
 1 Steel 3 RMP (SR) 5 Wrought iron 8 Concrete tile CASING JOINTS: Glued Clamped
 2 PVC 4 ABS 6 Asbestos-Cement 9 Other (specify below) Welded
 7 Fiberglass Threaded
 Blank casing diameter 5 in. to 8 ft., Dia. in. to ft., Dia. in. to ft.
 Casing height above land surface 18 in., weight 2.29 lbs./ft. Wall thickness or gauge No. 214

TYPE OF SCREEN OR PERFORATION MATERIAL:
 1 Steel 3 Stainless steel 5 Fiberglass 8 RMP (SR) 10 Asbestos-cement
 2 Brass 4 Galvanized steel 6 Concrete tile 9 ABS 11 Other (specify)
 12 None used (open hole)

SCREEN OR PERFORATION OPENINGS ARE:
 1 Continuous slot 3 Mill slot 5 Gauzed wrapped 8 Saw cut 11 None (open hole)
 2 Louvered shutter 4 Key punched 6 Wire wrapped 9 Drilled holes
 7 Torch cut 10 Other (specify)

SCREEN-PERFORATED INTERVALS: From 8 ft. to 28 ft., From ft. to ft.
 From ft. to ft., From ft. to ft.
 GRAVEL PACK INTERVALS: From 8 ft. to 28 ft., From ft. to ft.
 From ft. to ft., From ft. to ft.

6) GROUT MATERIAL: 1 Neat cement 2 Cement grout 3 Bentonite 4 Other
 Grout intervals: From 3 ft. to 10 ft., From ft. to ft., From ft. to ft.

What is the nearest source of possible contamination:
 1 Septic tank 4 Lateral lines 7 Pit privy 10 Livestock pens 14 Abandoned water well
 2 Sewer lines 5 Cess pool 8 Sewage lagoon 11 Fuel storage 15 Oil well/Gas well
 3 Watertight sewer lines 6 Seepage pit 9 Feedyard 12 Fertilizer storage 16 Other (specify below)
 13 Insecticide storage
 Direction from well? West How many feet? 50'

FROM	TO	LITHOLOGIC LOG	FROM	TO	LITHOLOGIC LOG
0	5	Top soil			
5	13	Clay			
13	20	Clay + Little sand			
20	28	Shale			

7) CONTRACTOR'S OR LANDOWNER'S CERTIFICATION: This water well was (1) constructed, (2) reconstructed, or (3) plugged under my jurisdiction and was completed on (mo/day/year) 11-15-87 and this record is true to the best of my knowledge and belief. Kansas Water Well Contractor's License No. 473A This Water Well Record was completed on (mo/day/yr) 11-18-87 under the business name of Tyler Water Well Serv. by (signature) Pat 5/8

INSTRUCTIONS: Use typewriter or ballpoint pen. PLEASE PRESS FIRMLY and PRINT clearly. Please fill in blanks, underline or circle the correct answers. Send top three copies to Kansas Department of Health and Environment, Office of Oil Field and Environmental Geology, Regulation and Permitting Section, Topeka, Kansas 66620-7500, Telephone: 913-862-9360. Send one to WATER WELL OWNER and retain one for your records.