USE TYPEWRITER OR BALL POINT PEN-PRESS FIRMLY, PRINT CLEARLY.

WATER WELL RECORD
KSA 82a-1201-1215

ACD

Kansas Department of Health and Environment-Division of Environment
(Water well Contractors)
Topeka, Kansas 66620

1. Location of well:	County	Fraction	Section number	Township number	Range number
	Wallace	SE 1/4 SW 1/4 NE 1/4	17	T 14 S	R 39 E (W)

2. Distance and direction from nearest town or city:
4 East 4 South of Sharon Springs
Street address of well location if in city:

3. Owner of well: Frasier Farms
R.R. or street: Rt, 1
City, state, zip code: Sharon Springs, Kansas 67758

4. Locate with "X" in section below:

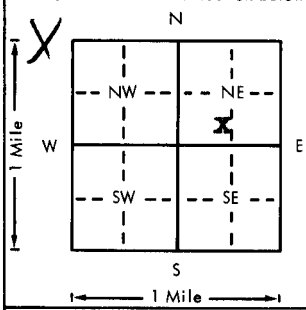

Sketch map:

6. Bore hole dia. 8 in. Completion date 6/1/78
Well depth 42 ft.

7. __ Cable tool X Rotary __ Driven __ Dug
__ Hollow rod __ Jetted __ Bored __ Reverse rotary

8. Use: X Domestic __ Public supply __ Industry
__ Irrigation __ Air conditioning __ Stock
__ Lawn __ Oil field water __ Other

9. Casing: Material plst Height: Above or below
Threaded ___ Welded gl Surface 15" in.
RMP X PVC ___ Weight ___ lbs./ft.
Dia. 5 in. to 42 ft. depth Wall Thickness: inches or
Dia. ___ in. to ___ ft. depth gage No. 3/8"

10. Screen: Manufacturer's name J and L
Type RMP Dia. 5"
Slot/gauze .032 Length 10
Set between 32 ft. and 42 ft.
___ ft. and ___ ft.
Gravel pack? yes Size range of material 1/8"

11. Static water level: mo./day/yr.
23 ft. below land surface Date 6/1/78

12. Pumping level below land surfaces:
___ ft. after NA hrs. pumping ___ g.p.m.
___ ft. after ___ hrs. pumping ___ g.p.m.
Estimated maximum yield ___ g.p.m.

13. Water sample submitted: mo./day/yr.
__ Yes X No Date ___

14. Well head completion:
yes Pitless adapter 20" Inches above grade

15. Well grouted? yes
With: X Neat cement __ Bentonite __ Concrete
Depth: From 4 ft. to 16 ft.

16. Nearest source of possible contamination:
ft. ___ Direction NA Type ___
Well disinfected upon completion? X Yes __ No

17. Pump: __ Not installed
Manufacturer's name Red Jacket
Model number ___ HP 1 Volts 230
Length of drop pipe 30 ft. capacity ___ g.p.m.
Type:
X Submersible __ Turbine
__ Jet __ Reciprocating
__ Centrifugal __ Other

5. Type and color of material

	From	To
Top Soil	0	12
Sand and Caly Strips	12	42
Shale	42	
BROCK 42'		

(Use a second sheet if needed)

18. Elevation:

Topography:
__ Hill
__ Slope
__ Upland
X Valley

19. Remarks:

20. Water well contractor's certification:
This well was drilled under my jurisdiction and this report is true to the best of my knowledge and belief.
Bartell Drilling 139
Business name License No.
Address Winona, Kansas 67764
Signed Joyce Bartell Date 10-7-78
Authorized representative

14 T 39 R E (W) 17 Sec SE 1/4 SW 1/4 NE 1/4

Forward the white, blue and pink copies to the Department of Health and Environment

Form WWC-5