


1 LOCATION OF WATER WELL: County: WALLACE Fraction: SW 1/4 SW 1/4 NE 1/4 Section Number: 31 Township Number: T 19S S Range Number: R 39 EAD

Distance and direction from nearest town or city street address of well if located within city?
8 South 2 EAST SHARON SPSS.

2 WATER WELL OWNER: Box RUSSELL WIRUH
 RR#, St. Address, Box #: 43
 City, State, ZIP Code: WALLACE, KS. 67761
 Board of Agriculture, Division of Water Resources
 Application Number:

3 LOCATE WELL'S LOCATION WITH AN "X" IN SECTION BOX:

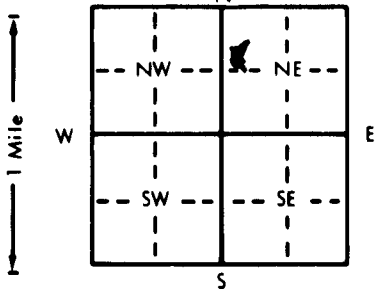

4 DEPTH OF COMPLETED WELL: 220 ft. ELEVATION: _____
 Depth(s) Groundwater Encountered 1. 120 ft. 2. _____ ft. 3. _____ ft.
 WELL'S STATIC WATER LEVEL: 120 ft. below land surface measured on mo/day/yr

Pump test data: Well water was _____ ft. after _____ hours pumping _____ gpm
 Est. Yield _____ gpm; Well water was _____ ft. after _____ hours pumping _____ gpm
 Bore Hole Diameter: 8 in. to 220 ft., and _____ in. to _____ ft.
 WELL WATER TO BE USED AS:
 Domestic 3 Feedlot 6 Oil field water supply 9 Dewatering 12 Other (Specify below)
 2 Irrigation 4 Industrial 7 Lawn and garden only 10 Monitoring well
 Was a chemical/bacteriological sample submitted to Department? Yes _____ No Yes; If yes, mo/day/yr sample was submitted
 Water Well Disinfected? Yes No

5 TYPE OF BLANK CASING USED:
 1 Steel 3 RMP (SR) 5 Wrought iron 8 Concrete tile CASING JOINTS: Glued Clamped _____
 PVC 4 ABS 6 Asbestos-Cement 9 Other (specify below) Welded _____
 7 Fiberglass Threaded _____

Blank casing diameter: 4.5 in. to 200 ft., Dia _____ in. to _____ ft., Dia _____ in. to _____ ft.
 Casing height above land surface: 18" in., weight SDR 26 lbs./ft. Wall thickness or gauge No. 160 KPS1

TYPE OF SCREEN OR PERFORATION MATERIAL:
 1 Steel 3 Stainless steel 5 Fiberglass 8 RMP (SR) 10 Asbestos-cement
 2 Brass 4 Galvanized steel 6 Concrete tile 9 ABS 11 Other (specify) _____
 12 None used (open hole)

SCREEN OR PERFORATION OPENINGS ARE:
 1 Continuous slot 3 Mill slot 5 Gauzed wrapped Saw cut 11 None (open hole)
 2 Louvered shutter 4 Key punched 6 Wire wrapped 9 Drilled holes
 7 Torch cut 10 Other (specify) _____

SCREEN-PERFORATED INTERVALS: From 200 ft. to 220 ft., From _____ ft. to _____ ft.
 GRAVEL PACK INTERVALS: From 100 ft. to 220 ft., From _____ ft. to _____ ft.
 From _____ ft. to _____ ft., From _____ ft. to _____ ft.

6 GROUT MATERIAL: Neat cement 2 Cement grout Hot plus 3 Bentonite 4 Other _____
 Grout intervals: From 5 ft. to 25 ft., From 80 ft. to 100 ft., From _____ ft. to _____ ft.

What is the nearest source of possible contamination:
 1 Septic tank 4 Lateral lines 7 Pit privy 10 Livestock pens 14 Abandoned water well
 2 Sewer lines 5 Cess pool 8 Sewage lagoon 11 Fuel storage 15 Oil well/Gas well
 3 Watertight sewer lines 6 Seepage pit 9 Feedyard 12 Fertilizer storage 16 Other (specify below)
 13 Insecticide storage

Direction from well? NW How many feet? 100'

FROM	TO	LITHOLOGIC LOG	FROM	TO	PLUGGING INTERVALS
0	50	Gravel Sand Clay			
50	85	sandstone gravel sand clay			
85	105	Gravel Sand			
105	125	Gravel Sand Clay			
125	155	sandstone sand clay			
155	185	Gravel sand clay			
185	220	Gravel sand clay			
220		Shale			

7 CONTRACTOR'S OR LANDOWNER'S CERTIFICATION: This water well was (1) constructed, (2) reconstructed, or (3) plugged under my jurisdiction and was completed on (mo/day/year) 9-23-93 and this record is true to the best of my knowledge and belief. Kansas Water Well Contractor's License No. 484 This Water Well Record was completed on (mo/day/yr) 9-23-92 under the business name of Schmitt Drilling by (signature) Russell Wiruh

INSTRUCTIONS: Use typewriter or ball point pen. PLEASE PRESS FIRMLY and PRINT clearly. Please fill in blanks, underline or circle the correct answers. Send top three copies to Kansas Department of Health and Environment, Bureau of Water, Topeka, Kansas 66620-0001. Telephone: 913-296-5545. Send one to WATER WELL OWNER and retain one for your records.