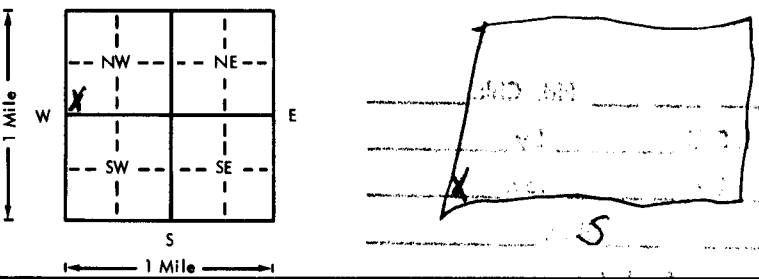


# SOUTH FLATS

USE TYPEWRITER OR BALL POINT PEN-PRESS FIRMLY, PRINT CLEARLY.

B10  
WATER WELL RECORD  
KSA 82a-1201-1215

Kansas Department of Health and Environment  
Division of Environment  
(Water well Contractors)  
Topeka, Kansas 66620

1. Location of well: County <b>WALLACE</b> Fraction <b>S 1/4 SW 1/4 SW 1/4 NW 1/4</b> Section number <b>31</b> Township number <b>T 14 S R 39 E NW</b> Range number <b>39</b>	
2. Distance and direction from nearest town or city: <b>1/2 MI E of WALLACE.</b> 3. Owner of well: <b>RUSSELL ZINRUH</b> R.R. or street: <b>SHARON SPRINGS KANS</b> City, state, zip code: <b>67735</b>	
4. Locate with "X" in section below: Sketch map: 	
5. Type and color of material	
	From To
Clay Gravel & Sandstone	0 116
Sand	116 131
Gravel	131 150
Sandy clay	150 160
Gravel	160 171
Clay & Sandstone	171 180
Gravel	180 203
Clay	203 205
Gravel	205 211
Clay Gravel & Sandstone	211 224
Soapstone	224 231
Shale	231 236
(Use a second sheet if needed)	
18. Elevation: Topography: <input checked="" type="checkbox"/> Hill <input checked="" type="checkbox"/> Slope <input type="checkbox"/> Upland <input type="checkbox"/> Valley	19. Remarks: <b>3624 (TOPO) Concrete Run By Foust Supply Co Inc</b>
6. Bore hole dia. <b>24</b> in. Completion date <b>5-19-76</b> Well depth <b>236</b> ft.	
7. <input type="checkbox"/> Cable tool <input type="checkbox"/> Rotary <input type="checkbox"/> Driven <input type="checkbox"/> Dug <input type="checkbox"/> Hollow rod <input type="checkbox"/> Jetted <input type="checkbox"/> Bored <input checked="" type="checkbox"/> Reverse rotary	
8. Use: <input checked="" type="checkbox"/> Domestic <input type="checkbox"/> Public supply <input type="checkbox"/> Industry <input checked="" type="checkbox"/> Irrigation <input type="checkbox"/> Air conditioning <input type="checkbox"/> Stock <input type="checkbox"/> Lawn <input type="checkbox"/> Oil field water <input type="checkbox"/> Other	
9. Casing: Material <b>STEEL</b> Height: Above or below Threaded <input type="checkbox"/> Welded <input checked="" type="checkbox"/> Surface <b>8</b> in. RMP <input type="checkbox"/> PVC <input type="checkbox"/> Weight <b>32</b> lbs./ft. Dia. <b>8</b> in. to <b>136</b> ft. depth   Wall Thickness: inches or Dia. <input type="checkbox"/> in. to <input type="checkbox"/> ft. depth   gage No. <b>188</b>	
10. Screen: Manufacturer's name <b>W.A. BROWN</b> Type <b>Mill salt</b> Dia. <b>16</b> Slot/gauze <input type="checkbox"/> Length <b>100</b> Set between <b>136</b> ft. and <b>236</b> ft. Gravel pack? <input checked="" type="checkbox"/> Size range of material <input type="checkbox"/>	
11. Static water level: <input type="checkbox"/> mo./day/yr. <b>120</b> ft. below land surface Date <b>5-19-76</b>	
12. Pumping level below land surfaces: <b>180</b> ft. after <b>8</b> hrs. pumping <b>800</b> g.p.m. <b>240</b> ft. after <b>16</b> hrs. pumping <b>1380</b> g.p.m. Estimated maximum yield <b>1280</b> g.p.m.	
13. Water sample submitted: <input type="checkbox"/> Yes <input checked="" type="checkbox"/> No Date <input type="checkbox"/>	
14. Well head completion: <input type="checkbox"/> Pitless adapter <input type="checkbox"/> Inches above grade	
15. Well grouted? <input checked="" type="checkbox"/> With: <input checked="" type="checkbox"/> Neat cement <input type="checkbox"/> Bentonite <input type="checkbox"/> Concrete Depth: From <b>8"</b> to <b>10</b> ft. Below	
16. Nearest source of possible contamination: <b>Field</b> ft. <b>100</b> Direction <b>SW</b> Type <b>conc</b> Well disinfected upon completion? <input type="checkbox"/> Yes <input type="checkbox"/> No	
17. Pump: Not installed Manufacturer's name <b>AFC TAIL</b> Model number <b>61000A</b> HP <input type="checkbox"/> Volts <input type="checkbox"/> Length of drop pipe <b>220</b> ft. capacity <b>1200</b> g.p.m. Type: <input type="checkbox"/> Submersible <input checked="" type="checkbox"/> Turbine <input type="checkbox"/> Jet <input type="checkbox"/> Reciprocating <input type="checkbox"/> Centrifugal <input type="checkbox"/> Other	
20. Water well contractor's certification: This well was drilled under my jurisdiction and this report is true to the best of my knowledge and belief. <b>Foust Supply Co Inc 144</b> Business name License No. Address <b>Box 338</b> Signed <b>Robert Elyman</b> Date <b>2-25-77</b> Authorized representative	

L4 39 E 31 SW SW NW 1/4 1/4 1/4