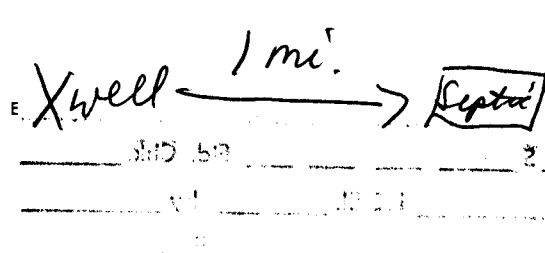


USE TYPEWRITER OR BALL POINT PEN-PRESS FIRMLY, PRINT CLEARLY.

WATER WELL RECORD
KSA 82a-1201-1215

Kansas Department of Health and Environment-Division of Environment
(Water well Contractors)
Topeka, Kansas 66620

BBC

1. Location of well:		County Wallace	Fraction SW 1/4 NW 1/4 NW 1/4	Section number 36	Township number T 14 S R 39 E	Range number 39
2. Distance and direction from nearest town or city: 16N, 3 1/2W, 6N, Street address of well location if in city: 1W, 1/2N of Selkirk, KS			3. Owner of well: Sam Bontrager R.R. or street: RFD #2 City, state, zip code: Scott City, KS 67871			
4. Locate with "X" in section below: N W S 1 Mile		Sketch map: 		6. Bore hole dia. 26 in. Completion date _____ Well depth 178 ft. 4-12-75		
5. Type and color of material		From	To	7. Cable tool ___ Rotary ___ Driven ___ Dug ___ Hollow rod ___ Jetted ___ Bored <input checked="" type="checkbox"/> Reverse rotary		
Clay		0	36	8. Use: ___ Domestic ___ Public supply ___ Industry <input checked="" type="checkbox"/> Irrigation ___ Air conditioning ___ Stock ___ Lawn ___ Oil field water ___ Other		
Gyp		36	38	9. Casing: Material Steel Height: Above or below Threaded ___ Welded <input checked="" type="checkbox"/> Surface 10 in. RMP ___ PVC Weight 31.67 lbs./ft. Dia. 16 in. to 178 ft. depth Wall Thickness: inches or Dia. ___ in. to ___ ft. depth gage No. .188		
Clay		38	47	10. Screen: Manufacturer's name _____ Free Flow Type Prime Steel Dia. 16 in. Flow gauze 125 Length 30 ft. Set between 148 ft. and 178 ft. Gravel pack? yes Size range of material 5/8-1/4		
Sd coarse		47	52	11. Static water level: _____ mo./day/yr. 126 ft. below land surface Date 3-18-75		
Sd rock		52	54	12. Pumping level below land surfaces: 152 ft. after 4 hrs. pumping 180 g.p.m. 162 ft. after 4 hrs. pumping 250 g.p.m. Estimated maximum yield 250 g.p.m.		
Clay		54	78	13. Water sample submitted: _____ mo./day/yr. Yes <input checked="" type="checkbox"/> No ___ Date _____		
Sd coarse		78	88	14. Well head completion: ___ Pitless adapter _____ inches above grade		
Clay sdy		88	96	<input checked="" type="checkbox"/> Well grouted? <input checked="" type="checkbox"/> With: ___ Neat cement ___ Bentonite <input checked="" type="checkbox"/> Concrete Depth: From X 0 ft. to X 15 ft.		
Fine sd clay		96	119	16. Nearest source of possible contamination: ft. 5280 Direction E Type Septic Well disinfected upon completion? <input checked="" type="checkbox"/> Yes ___ No		
Sd coarse		119	121	17. Pump: _____ Not installed Manufacturer's name Goulds Model number JH66MM34 HP 15 Volts 460 Length of drop pipe 170 ft. capacity 250 g.p.m. Type: <input checked="" type="checkbox"/> Submersible ___ Turbine ___ Jet ___ Reciprocating ___ Centrifugal ___ Other		
Clay		121	150	20. Water well contractor's certification: This well was drilled under my jurisdiction and this report is true to the best of my knowledge and belief. Weishaar Drilling 232 Business name _____ License No. _____ Address Scott City, KS 67871 Signed _____ Date 7-19-76 Authorized representative		
Sd coarse		150	162			
Clay yellow		162	165			
Shale (Use a second sheet if needed)		165	168			
18. Elevation:		19. Remarks: BROCK 168'				
Topography: ___ Hill ___ Slope <input checked="" type="checkbox"/> Upland ___ Valley						

14 390 36 SW 1/4 1/4