


WATER WELL RECORD Form WWC-5 KSA 82a-1212

Distance and direction from nearest town or city street address of well if located within city?

2 WATER WELL OWNER: DARVIV BACON

3	LOCATE WELL'S LOCATION WITH	4	DEPTH OF COMPLETED WELL. 49.6 ft. ELEVATION:
---	-----------------------------	---	--

WELL'S STATIC WATER LEVEL 19.2 ... ft. below land surface measured on mo/day/yr

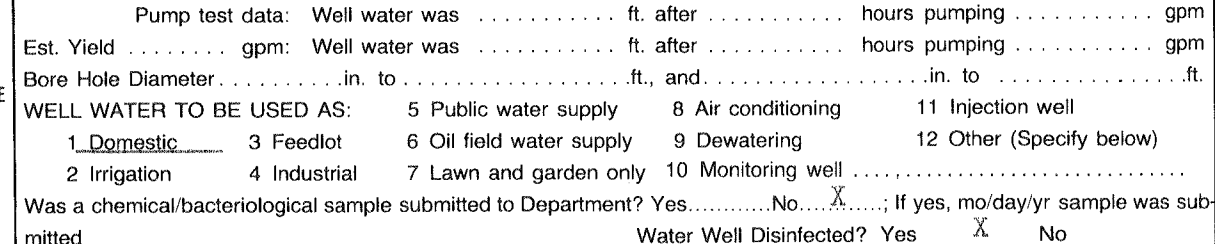

1 Steel 3 RMP (SR) 6 Asbestos-Cement 9 Other (specify below) Welded

Blank casing diameter in. to ft., Dia in. to ft., Dia in. to ft., Dia in. to ft.

1 Steel 3 Stainless steel 5 Fiberglass 8 RMP (SR) 11 Other (specify) ... *NA*

SCREEN OR PERFORATION OPENINGS ARE: 5 Gauzed wrapped 8 Saw cut 11 None (open hole)

2 Louvered shutter	4 Key punched	7 Torch cut	10 Other (specify) <i>7/11</i>
.....

GRAVEL PACK INTERVALS: From _____ ft. to _____ ft. From _____ ft. to _____ ft.

6 GROUT MATERIAL: 1 Neat cement 2 Cement grout 3 Bentonite 4 Other

What is the nearest source of possible contamination:	10 Livestock pens	14 Abandoned water well
1. Contaminated surface water	11 Fuel storage	15 Oil well/Gas well

2 Sewer lines	5 Sods pool	9 Sewage lagoon	12 Fertilizer storage
3 Watertight sewer lines	6 Seepage pit	9 Feedyard	13 Insecticide storage

FROM	TO	LITHOLOGIC LOG	FROM	TO	PLUGGING INTERVALS
------	----	----------------	------	----	--------------------

7. CONTRACTOR'S OR LANDOWNER'S CERTIFICATION: This water well was (1) constructed (2) reconstructed or (3) plugged under my jurisdiction and was

Water Well Contractor's License No. 388 This Water Well Record was completed on (mo/day/yr) 13/19/96


INSTRUCTIONS: Use typewriter or ball point pen. PLEASE PRESS FIRMLY and PRINT clearly. Please fill in blanks, underline or circle the correct answers. Send top three copies to Kansas Department of Health and Environment, Bureau of Water, Topeka, Kansas 66620-0001. Telephone: 913-296-5545. Send one to WATER WELL OWNER and retain one for your records.