


revised

WATER WELL PLUGGING RECORD Form WWC-5P KSA 82a-1212 ID NO. MW8

1 LOCATION OF WATER WELL: County: Saline Fraction NW 1/4 SE 1/4 SE 1/4 SW 1/4 Section Number 27 Township Number T 14 S Range Number 4 [] E [X] W

Street/Rural Address of Well Location; if unknown, distance & direction from nearest town or intersection: If at owner's address, check here [] 2364 South Midland Road Bavaria, KS Global Positioning Systems (GPS) information: Latitude: 38.79952 (in decimal degrees) Longitude: 97.75379 (in decimal degrees) Elevation: 1269.64 Horizontal Datum: [] WGS84, [X] NAD83, [] NAD27 Collection Method:

2 WATER WELL OWNER: Mid Kansas Cooperative Assn. RR#, St. Address, Box #: PO Box D City, State ZIP Code: Moundridge, KS 67107 Est. Accuracy: [X] < 3 m, [] 3-5 m, [] 5-15 m, [] > 15 m

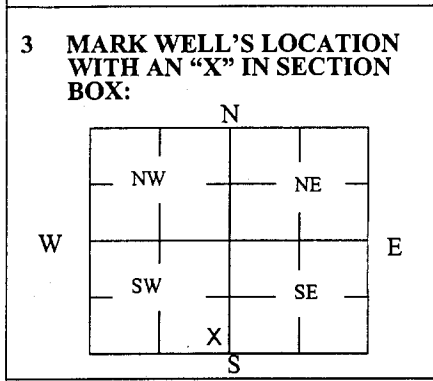

4 DEPTH OF WELL 25.07 ft. WELL'S STATIC WATER LEVEL 20.11 ft. WELL WAS USED AS: [] Domestic [] Irrigation [] Feedlot [] Industrial [] Public Water Supply [] Oil Field Water Supply [] Domestic (Lawn & Garden) [] Air Conditioning [] Dewatering [X] Monitoring [] Injection Well [] Other Was a chemical/bacteriological sample submitted to Department? Yes [] No [X]

5 TYPE OF BLANK CASING USED: [] Steel [X] PVC [] RMP (SR) [] ABS [] Wrought [] Asbestos-Cement [] Fiberglass [] Concrete Tile [] Other (Specify below) Blank casing diameter 2 in. Was casing pulled? Yes [X] No [] If yes, how much 3 ft Casing height above or below land surface -36 in.

6 GROUT PLUG MATERIAL: [] Neat cement [] Cement grout [X] Bentonite [] Other Grout Plug Intervals: From 3 ft. to 25.07 ft., From ft. to ft., From ft. to ft.

What is the nearest source of possible contamination: [] Septic tank [] Sewer lines [] Watertight sewer lines [] Lateral lines [] Cess pool [] Seepage pit [] Pit privy [] Sewage lagoon [] Feedyard [] Livestock pens [] Fuel storage [X] Fertilizer storage [] Insecticide storage [] Abandoned water well [] Oil well/Gas well [] Other (specify below) Direction from well? SW How many feet? 150

Table with columns: FROM, TO, PLUGGING MATERIALS. Row 1: 0, 3, Compacted Silt/Clay. Row 2: 3, 25.07, Hydradrated Bentonite Chips.

7 CONTRACTOR'S OR LANDOWNER'S CERTIFICATION: This water well was plugged under my jurisdiction and was completed on (mo/day/year) 10/24/2016 and this record is true to the best of my knowledge and belief. Kansas Water Well Contractor's License No. 585 This Water Well Record was completed on (mo/day/year) 11/2/2016 under the business name of Associated Environmental, Inc. by (signature)

Send one white copy to Kansas Department of Health & Environment, Geology Section, 1000 SW Jackson Street, Ste. 420, Topeka, KS 66612-1367. Send one copy to WATER WELL OWNER and retain one for your records. Visit us at http://www.kdheks.gov/waterwell/index.html Telephone 785-296-5524.