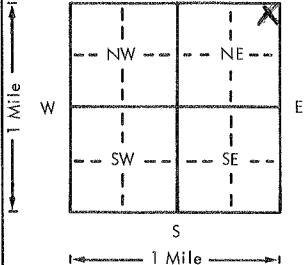


USE TYPEWRITER OR BALL
POINT PEN-PRESS FIRMLY,
PRINT CLEARLY.

WATER WELL RECORD
KSA 82a-1201-1215

Kansas Department of Health and
Environment-Division of Environment
(Water well Contractors)
Topeka, Kansas 66620

1. Location of well:	County Saline	Fraction NE 1/4 NE 1/4 NE 1/4	Section number 14	Township number T 14 S	Range number R 4 E
2. Distance and direction from nearest town or city: Street address of well location if in city:		3. Owner of well: Bernard White R.R. or street: R.R. # 1 City, state, zip code: Salina, Kansas 67401			
4. Locate with "X" in section below: Sketch map: 		6. Bore hole dia. .8 in. Completion date 5/13/77 Well depth 55 ft.			
5. Type and color of material		From	To	7. <input checked="" type="checkbox"/> Cable tool <input checked="" type="checkbox"/> Rotary <input type="checkbox"/> Driven <input type="checkbox"/> Dug <input type="checkbox"/> Hollow rod <input type="checkbox"/> Jetted <input type="checkbox"/> Bored <input type="checkbox"/> Reverse rotary	
Top soil		0	3	8. Use: <input checked="" type="checkbox"/> Domestic <input type="checkbox"/> Public supply <input type="checkbox"/> Industry <input type="checkbox"/> Irrigation <input type="checkbox"/> Air conditioning <input type="checkbox"/> Stock <input type="checkbox"/> Lawn <input type="checkbox"/> Oil field water <input type="checkbox"/> Other	
Brown clay		3	15	9. Casing: Material plst Height: Above or below Threaded <input type="checkbox"/> Welded gl Surface 18 in. RMP <input checked="" type="checkbox"/> PVC <input type="checkbox"/> Weight <input type="checkbox"/> lbs./ft. Dia. 5 in. to 55 ft. depth Wall Thickness: inches or Dia. <input type="checkbox"/> in. to <input type="checkbox"/> ft. depth gage No. 0.258	
Fine sand		15	35	10. Screen: Manufacturer's name Western Plastics Type RMP Dia. 5 1/2 Slot/gauze 3/32 Length 15 Set between 40 ft. and 55 ft. <input type="checkbox"/> ft. and <input type="checkbox"/> ft. Gravel pack? Yes Size range of material 1/16 to 3/16	
Brown clay		35	37	11. Static water level: 15 ft. below land surface Date 5/13/77	
Fine sand		37	40	12. Pumping level below land surfaces: ____ ft. after ____ hrs. pumping ____ g.p.m. ____ ft. after ____ hrs. pumping ____ g.p.m. Estimated maximum yield 20 g.p.m.	
Small gravel		40	48	13. Water sample submitted: ____ mo./day/yr. <input type="checkbox"/> Yes <input checked="" type="checkbox"/> No Date ____	
Brown clay		48	53	14. Well head completion: <input type="checkbox"/> Pitless adapter 18 inches above grade	
Blue mud		53	55	15. Well grouted? Yes With: <input checked="" type="checkbox"/> Neat cement <input type="checkbox"/> Bentonite <input type="checkbox"/> Concrete Depth: From 0 ft. to 10 ft.	
				16. Nearest source of possible contamination: ft. 100 Direction North Type sewer Well disinfected upon completion? <input checked="" type="checkbox"/> Yes <input type="checkbox"/> No	
				17. Pump: <input checked="" type="checkbox"/> Not installed Manufacturer's name _____ Model number _____ HP _____ Volts _____ Length of drop pipe _____ ft. capacity _____ g.p.m. Type: <input type="checkbox"/> Submersible <input type="checkbox"/> Turbine <input type="checkbox"/> Jet <input type="checkbox"/> Reciprocating <input type="checkbox"/> Centrifugal <input type="checkbox"/> Other	
		(Use a second sheet if needed)			
18. Elevation: Topography: <input type="checkbox"/> Hill <input type="checkbox"/> Slope <input type="checkbox"/> Upland <input checked="" type="checkbox"/> Valley	19. Remarks:			20. Water well contractor's certification: This well was drilled under my jurisdiction and this report is true to the best of my knowledge and belief. Rader Drilling Co. 194 Business name License No. Address Carlton, Kansas 67429 Signed Brent E. Rader Date 5-23-77 Authorized representative	

Forward the white, blue and pink copies to the Department of Health and Environment

Form WWC-5