

1 LOCATION OF WATER WELL:	Fraction	Section Number	Township Number	Range Number
County: <u>Saline</u>	<u>SE</u> $\frac{1}{4}$ <u>SE</u> $\frac{1}{4}$ <u>NE</u> $\frac{1}{4}$	<u>22</u>	T <u>14</u> S	R <u>4</u>

Distance and direction from nearest town or city street address of well if located within city?

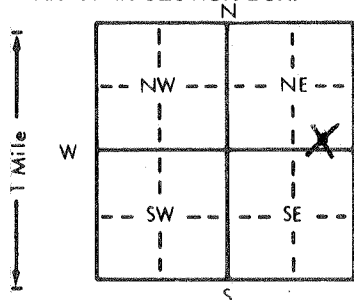
1 Mile East and 1 1/2 Mile North of Bavaria, KS2 WATER WELL OWNER: Rolling Hills Ranch c/o Charlie WalkerRR#, St. Address, Box # : R.R. 1

Board of Agriculture, Division of Water Resources

City, State, ZIP Code : Salina, KS 67401

Application Number:

3 LOCATE WELL'S LOCATION WITH AN "X" IN SECTION BOX:	4 DEPTH OF COMPLETED WELL: <u>47</u> ft. ELEVATION:
--	---


WELL WATER TO BE USED AS: 5 Public water supply 8 Air conditioning 11 Injection well

① Domestic 3 Feedlot 6 Oil field water supply 9 Dewatering 12 Other (Specify below)

2 Irrigation 4 Industrial 7 Lawn and garden only 10 Monitoring well Stock WellWas a chemical/bacteriological sample submitted to Department? Yes X No X; If yes, mo/day/yr sample was submittedWater Well Disinfected? Yes X No X

5 TYPE OF BLANK CASING USED:	5 Wrought iron	8 Concrete tile	CASING JOINTS: Glued <u>X</u> Clamped
------------------------------	----------------	-----------------	---------------------------------------

1 Steel 3 RMP (SR) 6 Asbestos-Cement 9 Other (specify below) Welded

2 PVC 4 ABS 7 Fiberglass Threaded


TYPE OF SCREEN OR PERFORATION MATERIAL:	7 PVC	10 Asbestos-cement
---	-------	--------------------

1 Steel 3 Stainless steel 5 Fiberglass 8 RMP (SR) 11 Other (specify)

2 Brass 4 Galvanized steel 6 Concrete tile 9 ABS 12 None used (open hole)

SCREEN OR PERFORATION OPENINGS ARE:	5 Gauzed wrapped	8 Saw cut	11 None (open hole)
-------------------------------------	------------------	-----------	---------------------

1 Continuous slot 3 Mill slot 6 Wire wrapped 9 Drilled holes

2 Louvered shutter 4 Key punched 7 Torch cut 10 Other (specify)



6 GROUT MATERIAL:	1 Neat cement	2 Cement grout	3 Bentonite	4 Other
-------------------	---------------	----------------	-------------	---------

Grout Intervals: From 0 ft. to 20 ft. From 0 ft. to 20 ft. From 0 ft. to 20 ft.

What is the nearest source of possible contamination:

1 Septic tank 4 Lateral lines 7 Pit privy 10 Livestock pens 14 Abandoned water well

2 Sewer lines 5 Cess pool 8 Sewage lagoon 11 Fuel storage 15 Oil well/Gas well

3 Watertight sewer lines 6 Seepage pit 9 Feedyard 12 Fertilizer storage 16 Other (specify below)

13 Insecticide storage

Direction from well? NE How many feet? 4500 ft

FROM	TO	LITHOLOGIC LOG	FROM	TO	PLUGGING INTERVALS
------	----	----------------	------	----	--------------------

0	3	Top Soil			
3	12	Sandy Brown Clay			
12	18	Fine Sand			
18	32	Brown Clay			
32	40	Clean Creek Gravel			
40	41	Brown Clay			
41	46	Fine Sand & Creek Gravel			
46	47	Gray Shale			

7 CONTRACTOR'S OR LANDOWNER'S CERTIFICATION: This water well was (1) constructed, (2) reconstructed, or (3) plugged under my jurisdiction and was completed on (mo/day/year) 11-6-89 and this record is true to the best of my knowledge and belief. KansasWater Well Contractor's License No. 138 This Water Well Record was completed on (mo/day/yr) 11-15-89under the business name of Peterson Irrigation, Inc. by (signature) Mike Peterson