


LOCATION OF WATER WELL:		Fraction	Section Number			Township Number			Range Number		
County:	Saline	NE ¼ NW ¼ NW ¼	34			T 14 S			R 4 E		

Distance and direction from nearest town or city street address of well if located within city?

In city limits-Bavaria, KS

WATER WELL OWNER:	Mark Booher	
RR#, St. Address, Box # :	100 Geissler Rd.	Board of Agriculture, Division of Water Resources
City, State, ZIP Code :	Bavaria, KS 67401	Application Number:

LOCATE WELL'S LOCATION WITH AN "X" IN SECTION BOX: 4 DEPTH OF COMPLETED WELL: 4.7 ft. ELEVATION:   
 Depth(s) Groundwater Encountered 1. 25 ft. 2. ft. 3. ft.

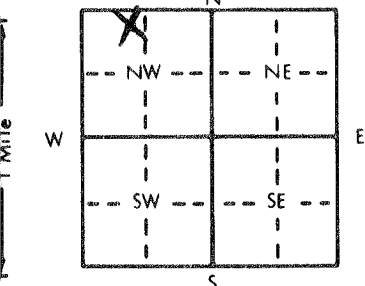

4 DEPTH OF COMPLETED WELL.....4.7..... ft. ELEVATION:.....  
 Depth(s) Groundwater Encountered 1. 2.5..... ft. 2. .... ft. 3. .... ft.  
 WELL'S STATIC WATER LEVEL ....25..... ft. below land surface measured on mo/day/yr ..8-22-91.....  
 Pump test data: Well water was ..... ft. after ..... hours pumping ..... gpm  
 Est. Yield .1.5..... gpm: Well water was ....33..... ft. after .1.1/2... hours pumping ....10..... gpm  
 Bore Hole Diameter...1.0... in. to ....4.7..... ft., and..... in. to ..... ft.  
 WELL WATER TO BE USED AS: 5 Public water supply 8 Air conditioning 11 Injection well  
 1 Domestic 3 Feedlot 6 Oil field water supply 9 Dewatering 12 Other (Specify below)  
 2 Irrigation 4 Industrial 7 Lawn and garden only 10 Monitoring well .....  
 Was a chemical/bacteriological sample submitted to Department? Yes.....No..X.....; If yes, mo/day/yr sample was sub  
 mitted Water Well Disinfected? Yes X No

TYPE OF BLANK CASING USED:		5 Wrought iron	8 Concrete tile	CASING JOINTS: Glued <input checked="" type="checkbox"/> . . . . . Clamped . . . . .
1 Steel	3 RMP (SR)	6 Asbestos-Cement	9 Other (specify below)	Welded . . . . .
2 PVC	4 ABS	7 Fiberglass	. . . . .	Threaded. . . . .

Blank casing diameter . . . 5 . . . in. to . . . 32 . . . ft., Dia . . . 42 . . . in. to . . . 47 . . . ft., Dia . . . in. to . . . ft.  
Casing height above land surface. . . . 12 . . . in., weight . . . 2.37 . . . lbs./ft. Wall thickness or gauge No. . . . 214 . . .

TYPE OF SCREEN OR PERFORATION MATERIAL:			7 PVC	10 Asbestos-cement
1 Steel	3 Stainless steel	5 Fiberglass	8 RMP (SR)	11 Other (specify) . . . . .
2 Brass	4 Galvanized steel	6 Concrete tile	9 ABS	12 None used (open hole)

SCREEN OR PERFORATION OPENINGS ARE:		5 Gauzed wrapped	8 Saw cut	11 None (open hole)
1 Continuous slot	3 Mill slot	6 Wire wrapped	9 Drilled holes	
2 Louvered shutter	4 Key punched	7 Torch cut	10 Other (specify) .....	

SCREEN-PERFORATED INTERVALS:	From . . . . . 32 . . . . .	ft. to . . . . . 42 . . . . .	ft., From . . . . .	ft. to . . . . .	ft.
	From . . . . .	ft. to . . . . .	ft., From . . . . .	ft. to . . . . .	ft.
GRAVEL PACK INTERVALS:	From . . . . . 25 . . . . .	ft. to . . . . . 47 . . . . .	ft., From . . . . .	ft. to . . . . .	ft.
	From . . . . .	ft. to . . . . .	ft., From . . . . .	ft. to . . . . .	ft.

GROUT MATERIAL:      1 Neat cement                      2 Cement grout                      3 Bentonite                      4 Other \_\_\_\_\_

Grout Intervals:    From 5 ft. to 25 ft.,    From \_\_\_\_\_ ft. to \_\_\_\_\_ ft.,    From \_\_\_\_\_ ft. to \_\_\_\_\_ ft.

What is the nearest source of possible contamination:

1 Septic tank	4 Lateral lines	7 Pit privy	10 Livestock pens	14 Abandoned water well
<u>2 Sewer lines</u>	5 Cess pool	8 Sewage lagoon	11 Fuel storage	15 Oil well/Gas well
3 Watertight sewer lines	6 Seepage pit	9 Feedyard	12 Fertilizer storage	16 Other (specify below)
			13 Insecticide storage	

Direction from well? North

How many feet? 80 ft

[illegible]

7 CONTRACTOR'S OR LANDOWNER'S CERTIFICATION: This water well was (1) constructed, (2) reconstructed, or (3) plugged under my jurisdiction and was completed on (mo/day/year) 8-22-91 and this record is true to the best of my knowledge and belief. Kansas Water Well Contractor's License No. 138 This Water Well Record was completed on (mo/day/yr) 8-29-91 under the business name of Peterson Irrigation, Inc. by (signature) Mike Peterson