

## WATER WELL RECORD Form WWC-5 KSA 82a-1212

LOCATION OF WATER WELL:	Fraction	Section Number	Township Number	Range Number
County: <u>SALINE</u>	SW ¼ SE ¼ SE ¼	28	T 14 S	R 4 E/W


Distance and direction from nearest town or city street address of well if located within city?

7357 W. MAGNOLIA ROAD

WATER WELL OWNER: REX BLOOD  
 RR#, St. Address, Box # : 7357 W. MAGNOLIA ROAD  
 City, State, ZIP Code : BARNES, KS. 67401

Board of Agriculture, Division of Water Resources  
 Application Number:

LOCATE WELL'S LOCATION WITH AN "X" IN SECTION BOX: 4 DEPTH OF COMPLETED WELL: 20 ft. ELEVATION: 1100

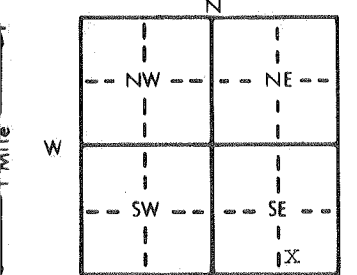

Depth(s) Groundwater Encountered 1. 4.5 ft. 2. ft. 3. ft.

WELL'S STATIC WATER LEVEL 13. ft. below land surface measured on mo/day/yr

Pump test data: Well water was 17. ft. after 1. hours pumping 5. gpm

Est. Yield 5. gpm: Well water was ft. after hours pumping gpm

Bore Hole Diameter 8 1/2. in. to 20. ft., and in. to ft.

WELL WATER TO BE USED AS:

1 Domestic	3 Feedlot	6 Oil field water supply	9 Dewatering	11 Injection well
2 Irrigation	4 Industrial	7 Lawn and garden only	10 Observation well	12 Other (Specify below)

Was a chemical/bacteriological sample submitted to Department? Yes.....No.....X.....; If yes, mo/day/yr sample was sub

S		mitted		Water Well Disinfected? Yes <input checked="" type="checkbox"/> No <input type="checkbox"/>	
TYPE OF BLANK CASING USED:		5 Wrought iron	8 Concrete tile	CASING JOINTS: Glued <input checked="" type="checkbox"/> Clamped <input type="checkbox"/>	
1 Steel	3 RMP (SR)	6 Asbestos-Cement	9 Other (specify below)	Welded <input type="checkbox"/>	
2 RMC	4 ABC	7 Fiberglass		Threaded <input type="checkbox"/>	

Blank casing diameter . . . 5 . . . in. to 15 . . . ft., Dia . . . in. to . . . ft., Dia . . . in. to . . . ft.  
Casing height above land surface . . . 12 . . . in. weight 160 . . . lbs./ft. Wall thickness or gauge No. SDR 26

TYPE OF SCREEN OR PERFORATION MATERIAL:					<u>7 PVC</u>	10 Asbestos-cement
1 Steel	3 Stainless steel	5 Fiberglass	8 RMP (SR)	11 Other (specify) . . . . .		
2 Brass	4 Galvanized steel	6 Concrete tile	9 ABS	12 None used (open hole)		

SCREEN OR PERFORATION OPENINGS ARE:

1 Continuous slot	3 Mill slot	5 Gauzed wrapped	8 Saw cut	11 None (open hole)
2 Louvered shutter	4 Key punched	6 Wire wrapped	9 Drilled holes	
		7 Torch cut	10 Other (specify) .....	

SCREEN-PERFORATED INTERVALS: From . . . 15 . . . . . ft. to . . . . . 20 . . . . . ft. From . . . . . ft. to . . . . . ft. From . . . . . ft. to . . . . . ft. From . . . . . ft. to . . . . . ft.

GRAVEL PACK INTERVALS: From 10 ft. to 20 ft., From ft. to ft.  
From ft. to ft. From ft. to ft.

GROUT MATERIAL:		1 Neat cement		2 Cement grout		3 Bentonite		4 Other	
Grout Intervals:	From	1	ft to	10	ft	From	ft to	ft	ft

What is the nearest source of possible contamination:			10 Livestock pens	14 Abandoned water well
1 <u>Septic tank</u>	4 Lateral lines	7 Pit privy	11 Fuel storage	15 Oil well/Gas well
2 Sewer lines	5 Cess pool	8 Sewage lagoon	12 Fertilizer storage	16 Other (specify below)
3 Watertight sewer lines	6 Seepage pit	9 Feedyard	13 Insecticide storage	

Direction from well? EAST How many feet? 50

[illegible]

7 CONTRACTOR'S OR LANDOWNER'S CERTIFICATION: This water well was (1) constructed, (2) reconstructed, or (3) plugged under my jurisdiction and was completed on (mo/day/year) . . . 6-3-88 . . . . . and this record is true to the best of my knowledge and belief. Kansas Water Well Contractor's License No. . . . 388 . . . . . This Water Well Record was completed on (mo/day/yr) 6-3-88 . . . . . under the business name of PESTINGER PUMP SERVICE by (signature) Paul Pestinger

INSTRUCTIONS: Use typewriter or ball point pen. PLEASE PRESS FIRMLY and PRINT clearly. Please fill in blanks, underline or circle the correct answers. Send top three copies to Kansas Department of Health and Environment, Bureau of Water Protection, Topeka, Kansas 66620-7320, Telephone: 913-862-9360. Send one to WATER WELL OWNER and retain one for your records.