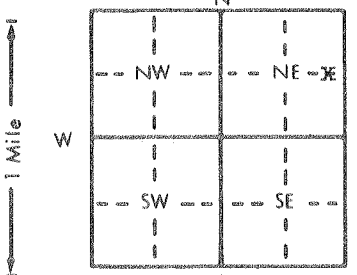


1 LOCATION OF WATER WELL:	Fraction	Section Number	Township Number	Range Number
County: <u>SALINE</u>	<u>NE</u> $\frac{1}{4}$ <u>SE</u> $\frac{1}{4}$ <u>NE</u> $\frac{1}{4}$	<u>36</u>	<u>T</u> <u>14</u> <u>S</u>	<u>R</u> <u>4</u> <u>EW</u>

Distance and direction from nearest town or city street address of well if located within city?

2548 S. LIGHTVILLE RD.

2 WATER WELL OWNER: <u>CHARLES SCHNIEDER</u>	Board of Agriculture, Division of Water Resources
RR#, St. Address, Box # : <u>2548 S. LIGHTVILLE RD.</u>	Application Number:
City, State, ZIP Code : <u>SALINA, KS. 67401</u>	

3 LOCATE WELL'S LOCATION WITH AN "X" IN SECTION BOX:	4 DEPTH OF COMPLETED WELL: <u>78</u> ft. ELEVATION: .....
	Depth(s) Groundwater Encountered 1. <u>36</u> ft. 2. .... ft. 3. .... ft.
	WELL'S STATIC WATER LEVEL <u>36</u> ft. below land surface measured on mo/day/yr <u>12-12-94</u>
	Pump test data: Well water was .... ft. after .... hours pumping .... gpm
	Est. Yield .... gpm: Well water was .... ft. after .... hours pumping .... gpm
	Bore Hole Diameter .... in. to .... ft., and .... in. to .... ft.
	WELL WATER TO BE USED AS:
	5 Public water supply 8 Air conditioning 11 Injection well
	1 Domestic 3 Feedlot 6 Oil field water supply 9 Dewatering 12 Other (Specify below)
	2 Irrigation 4 Industrial 7 Lawn and garden only 10 Monitoring well
	Was a chemical/bacteriological sample submitted to Department? Yes.....No.....; If yes, mo/day/yr sample was submitted
	Water Well Disinfected? Yes No

5 TYPE OF BLANK CASING USED:	5 Wrought iron	8 Concrete tile	CASING JOINTS: Glued ..... Clamped .....
1 Steel	3 RMP (SR)	6 Asbestos-Cement	9 Other (specify below) Welded .....
2 PVC	4 ABS	7 Fiberglass	..... Threaded .....
Blank casing diameter <u>6</u> in. to .... ft., Dia. .... in. to .... ft., Dia. .... in. to .... ft.			
Casing height above land surface .... in., weight .... lbs./ft. Wall thickness or gauge No. ....			
TYPE OF SCREEN OR PERFORATION MATERIAL:	7 PVC	10 Asbestos-cement	
1 Steel	3 Stainless steel	5 Fiberglass	8 RMP (SR)
2 Brass	4 Galvanized steel	6 Concrete tile	9 ABS
11 Other (specify) .....			12 None used (open hole)
SCREEN OR PERFORATION OPENINGS ARE:	5 Gauzed wrapped	8 Saw cut	11 None (open hole)
1 Continuous slot	3 Mill slot	6 Wire wrapped	9 Drilled holes
2 Louvered shutter	4 Key punched	7 Torch cut	10 Other (specify) <u>NA</u>
SCREEN-PERFORATED INTERVALS: From <u>NA</u> ft. to <u>NA</u> ft., From .... ft. to .... ft.			
From .... ft. to .... ft., From .... ft. to .... ft.			
GRAVEL PACK INTERVALS: From .... ft. to .... ft., From .... ft. to .... ft.			
From .... ft. to .... ft., From .... ft. to .... ft.			

6 GROUT MATERIAL:	1 Neat cement	2 Cement grout	<u>3 Bentonite</u>	4 Other .....
Grout Intervals: From <u>36</u> ft. to <u>4</u> ft., From .... ft. to .... ft., From .... ft. to .... ft.				
What is the nearest source of possible contamination:	10 Livestock pens	14 Abandoned water well		
1 Septic tank	4 Lateral lines	7 Pit privy	11 Fuel storage	15 Oil well/Gas well
2 Sewer lines	5 Cess pool	8 Sewage lagoon	12 Fertilizer storage	16 Other (specify below)
3 Watertight sewer lines	6 Seepage pit	9 Feedyard	13 Insecticide storage	<u>NONE</u>

Direction from well?	How many feet?
FROM TO LITHOLOGIC LOG FROM TO PLUGGING INTERVALS	
	<u>78</u> <u>36</u> CHLORATED GRAVEL
	<u>36</u> <u>4</u> BENTONITE HOLEPLUG
	<u>4</u> <u>0</u> FILL DIRT

7 CONTRACTOR'S OR LANDOWNER'S CERTIFICATION: This water well was (1) constructed, (2) reconstructed, or (3) plugged under my jurisdiction and was completed on (mo/day/year) <u>12-12-94</u> and this record is true to the best of my knowledge and belief. Kansas Water Well Contractor's License No. <u>388</u> This Water Well Record was completed on (mo/day/yr) <u>12-12-94</u> under the business name of <u>PESTINGER PUMP SERVICE</u> by (signature) <u>[Signature]</u>
---