


1 LOCATION OF WATER WELL: Fraction NE 1/4 NW 1/4 NE 1/4 Section Number 34 Township Number T 14 S Range Number R 40 SW
 County: Wallace

Distance and direction from nearest town or city street address of well if located within city?

2 WATER WELL OWNER: Vaughn M. Young Trust #2
 RR#, St. Address, Box #: Box 57 Board of Agriculture, Division of Water Resources
 City, State, ZIP Code: Tribune KS 67879 Application Number: 39,736

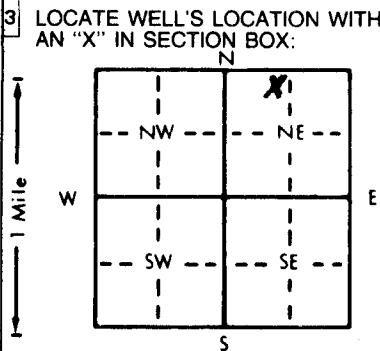

4 DEPTH OF COMPLETED WELL: 255 ft. ELEVATION:
 Depth(s) Groundwater Encountered 1. 160 ft. 2. ft. 3. ft.
 WELL'S STATIC WATER LEVEL 160 ft. below land surface measured on mo/day/yr 7-25-95
 Pump test data: Well water was 250 ft. after 3 hours pumping 1,000 gpm
 Est. Yield 1,000 gpm: Well water was ft. after hours pumping gpm
 Bore Hole Diameter 26 in. to 255 ft., and in. to ft.
 WELL WATER TO BE USED AS:
 1 Domestic 3 Feedlot 6 Oil field water supply 9 Dewatering 12 Other (Specify below)
 2 Irrigation 4 Industrial 7 Lawn and garden only 10 Monitoring well
 Was a chemical/bacteriological sample submitted to Department? Yes No If yes, mo/day/yr sample was submitted
 Water Well Disinfected? Yes No

5 TYPE OF BLANK CASING USED:
 1 Steel 3 RMP (SR) 5 Wrought iron 8 Concrete tile CASING JOINTS: Glued Clamped
 2 PVC 4 ABS 6 Asbestos-Cement 9 Other (specify below) Welded
 7 Fiberglass Threaded
 Blank casing diameter 16 in. to 215 ft., Dia in. to ft., Dia in. to ft.
 Casing height above land surface 12" in., weight lbs./ft. Wall thickness or gauge No. SDR26
 TYPE OF SCREEN OR PERFORATION MATERIAL:
 1 Steel 3 ~~Stainless~~ Agri steel 5 Fiberglass 7 PVC 10 Asbestos-cement
 2 Brass 4 Galvanized steel 6 Concrete tile 8 RMP (SR) 11 Other (specify)
 9 ABS 12 None used (open hole)
 SCREEN OR PERFORATION OPENINGS ARE:
 1 Continuous slot 3 Mill slot 5 Gauzed wrapped 8 Saw cut 11 None (open hole)
 2 Louvered shutter 4 Key punched 6 Wire wrapped 9 Drilled holes
 7 Torch cut 10 Other (specify)
 SCREEN-PERFORATED INTERVALS: From 215 ft. to 235 ft. From PVC Mill slot ft. to ft.
 From 235 ft. to 255 ft. From Steel Agri Screen ft. to ft.
 GRAVEL PACK INTERVALS: From 20 ft. to 255 ft. From ft. to ft.
 From ft. to ft.

6 GROUT MATERIAL: 1 Neat cement 2 Cement grout 3 Bentonite 4 Other
 Grout Intervals: From 0 ft. to 20 ft., From ft. to ft. From ft. to ft. From ft. to ft.
 What is the nearest source of possible contamination:
 1 Septic tank 4 Lateral lines 7 Pit privy 10 Livestock pens 14 Abandoned water well
 2 Sewer lines 5 Cess pool 8 Sewage lagoon 11 Fuel storage 15 Oil well/Gas well
 3 Watertight sewer lines 6 Seepage pit 9 Feedyard 12 Fertilizer storage 16 Other (specify below)
 13 Insecticide storage
 Direction from well? East How many feet? 1,000

FROM	TO	LITHOLOGIC LOG	FROM	TO	PLUGGING INTERVALS
0	16	Top soil & clay	165	175	Sand coarse & 2' clay
16	32	Limestone & clay	175	181	Sand (fine & tight) & little clay
32	49	Limestone & clay	181	193	Sand & limestone streaks (hard)
49	66	Limestone & sand	193	198	Sand (medium) 1' clay
66	82	Sand & little limestone (1' hard)	198	202	Sand medium
82	90	Sand & limestone	202	205	Limestone (very very hard)
90	99	Sandy clay	205	212	Cemented sand & little limestone
99	111	Sandy clay	212	214	Sand (coarse)
111	114	Limestone	214	225	Sand (medium to coarse) clean
114	132	Sand (fine) & little clay streaks	225	239	Sandy clay
132	136	Sand (medium to coarse)	239	243	Sand (medium to coarse)
136	148	Sandy clay & 3' medium to coarse sand	243	247	Sandy clay
148	152	Sandy clay	247	254	Clay
152	157	Sand medium	254	260	Shale
157	165	Sandy clay			

7 CONTRACTOR'S OR LANDOWNER'S CERTIFICATION: This water well was (1) constructed, (2) reconstructed, or (3) plugged under my jurisdiction and was completed on (mo/day/year) 7-21-95 and this record is true to the best of my knowledge and belief. Kansas Water Well Contractor's License No. 473 This Water Well Record was completed on (mo/day/yr) 7-25-95 under the business name of Tyler Water Well Service by (signature) [Signature]

OFFICE USE ONLY