

USE TYPEWRITER OR BALL POINT PEN-PRESS FIRMLY, PRINT CLEARLY.


WATER WELL RECORD
KSA 82a-1201-1215

DCC *Spring Valley Ranch*

Kansas Department of Health and Environment-Division of Environment
(Water well Contractors)
Topeka, Kansas 66620

1. Location of well: County Wallace Fraction SW 1/4 SW 1/4 SE 1/4 Section number 18 Township number T 14 Range number S R 40 E/W

2. Distance and direction from nearest town or city: SHARON SPRINGS 4.5 SE
Street address of well location if in city: RT 2 BOX 9
3. Owner of well: Edwin Selzer
R.R. or street: RT 2 BOX 9
City, state, zip code: Sharon Springs KS 67258

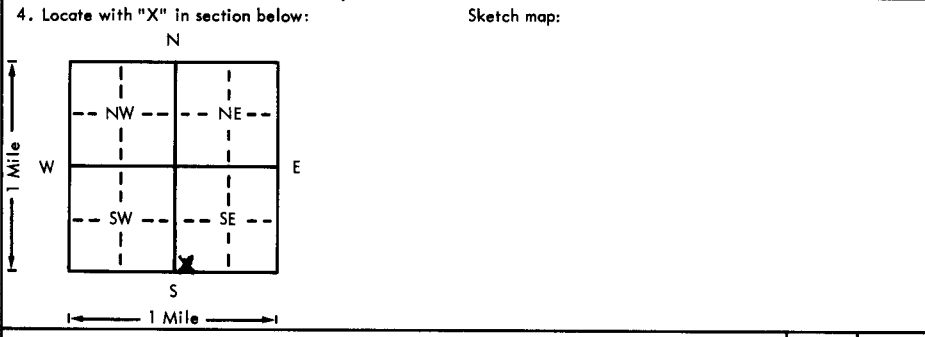

6. Bore hole dia. 4 in. Completion date 4-27-77
Well depth 176 ft.
7. Cable tool Rotary Driven Dug
 Hollow rod Jetted Bored Reverse rotary
8. Use: Domestic Public supply Industry
 Irrigation Air conditioning Stock
 Lawn Oil field water Other
9. Casing: Material Plastic Height: Above or below
Threaded Welded Surface 12 in.
RMP PVC Weight lbs./ft.
Dia. 4 in. to 180 ft. depth Wall Thickness: inches or
Dia. in. to ft. depth Gage No. 1237

5. Type and color of material

	From	To
<u>M GRAVEL, TRACE Clay</u>	<u>160</u>	<u>170</u>
<u>M GRAVEL</u>	<u>170</u>	<u>191</u>
<u>ochre</u>	<u>191</u>	<u>196</u>
<u>BROCK 191'</u>		

10. Screens: Manufacturer's name Jess + Lowell
Type Louyer Dia. 5
Slot/gauze 1/8 258 Length 16
Set between 180 ft. and 196 ft.
ft. and ft.
Gravel pack? yes Size range of material 1/8
11. Static water level: 165 ft. below land surface Date 1-10-77 mo./day/yr.
12. Pumping level below land surfaces:
190 ft. after 3 hrs. pumping 12 g.p.m.
 ft. after hrs. pumping g.p.m.
Estimated maximum yield 20 g.p.m.
13. Water sample submitted: Yes No Date mo./day/yr.
14. Well head completion: Pitless adapter inches above grade
15. Well grouted? yes
With: Neat cement Bentonite Concrete
Depth: From 0 ft. to 10 ft.
16. Nearest source of possible contamination: Pasture
ft. Direction Type Pasture
Well disinfected upon completion? Yes No
17. Pump: Not installed
Manufacturer's name Recaloss
Model number HP 1/4 Volts 220
Length of drop pipe 19.3 ft. capacity 10 g.p.m.
Type:
 Submersible Turbine
 Jet Reciprocating
 Centrifugal Other

18. Elevation: 3738 ftm
Topography: Hill Slope Upland Valley

19. Remarks:
3738
191
3547

20. Water well contractor's certification:
This well was drilled under my jurisdiction and this report is true to the best of my knowledge and belief.
A H Dulling Co Inc 166
Business name Woodham Kansas License No.
Address Woodham Kansas
Signed Bill Clifford Date 4-29-77
Authorized representative

14
40
18
S
W
S
W
S
E
1/4
1/4
1/4